


LEGEND	
()	RECORD DATA PER REFERENCE LIST ON SHEET 2
★	SET GPS CONTROL POINT SEE TABLE ON SHEET 3
○	FOUND MONUMENT
—	RESOLVED RIGHT OF WAY
---	EXISTING RIGHT OF WAY OR PROPERTY LINE
- - -	SUBDIVISION LOT LINE

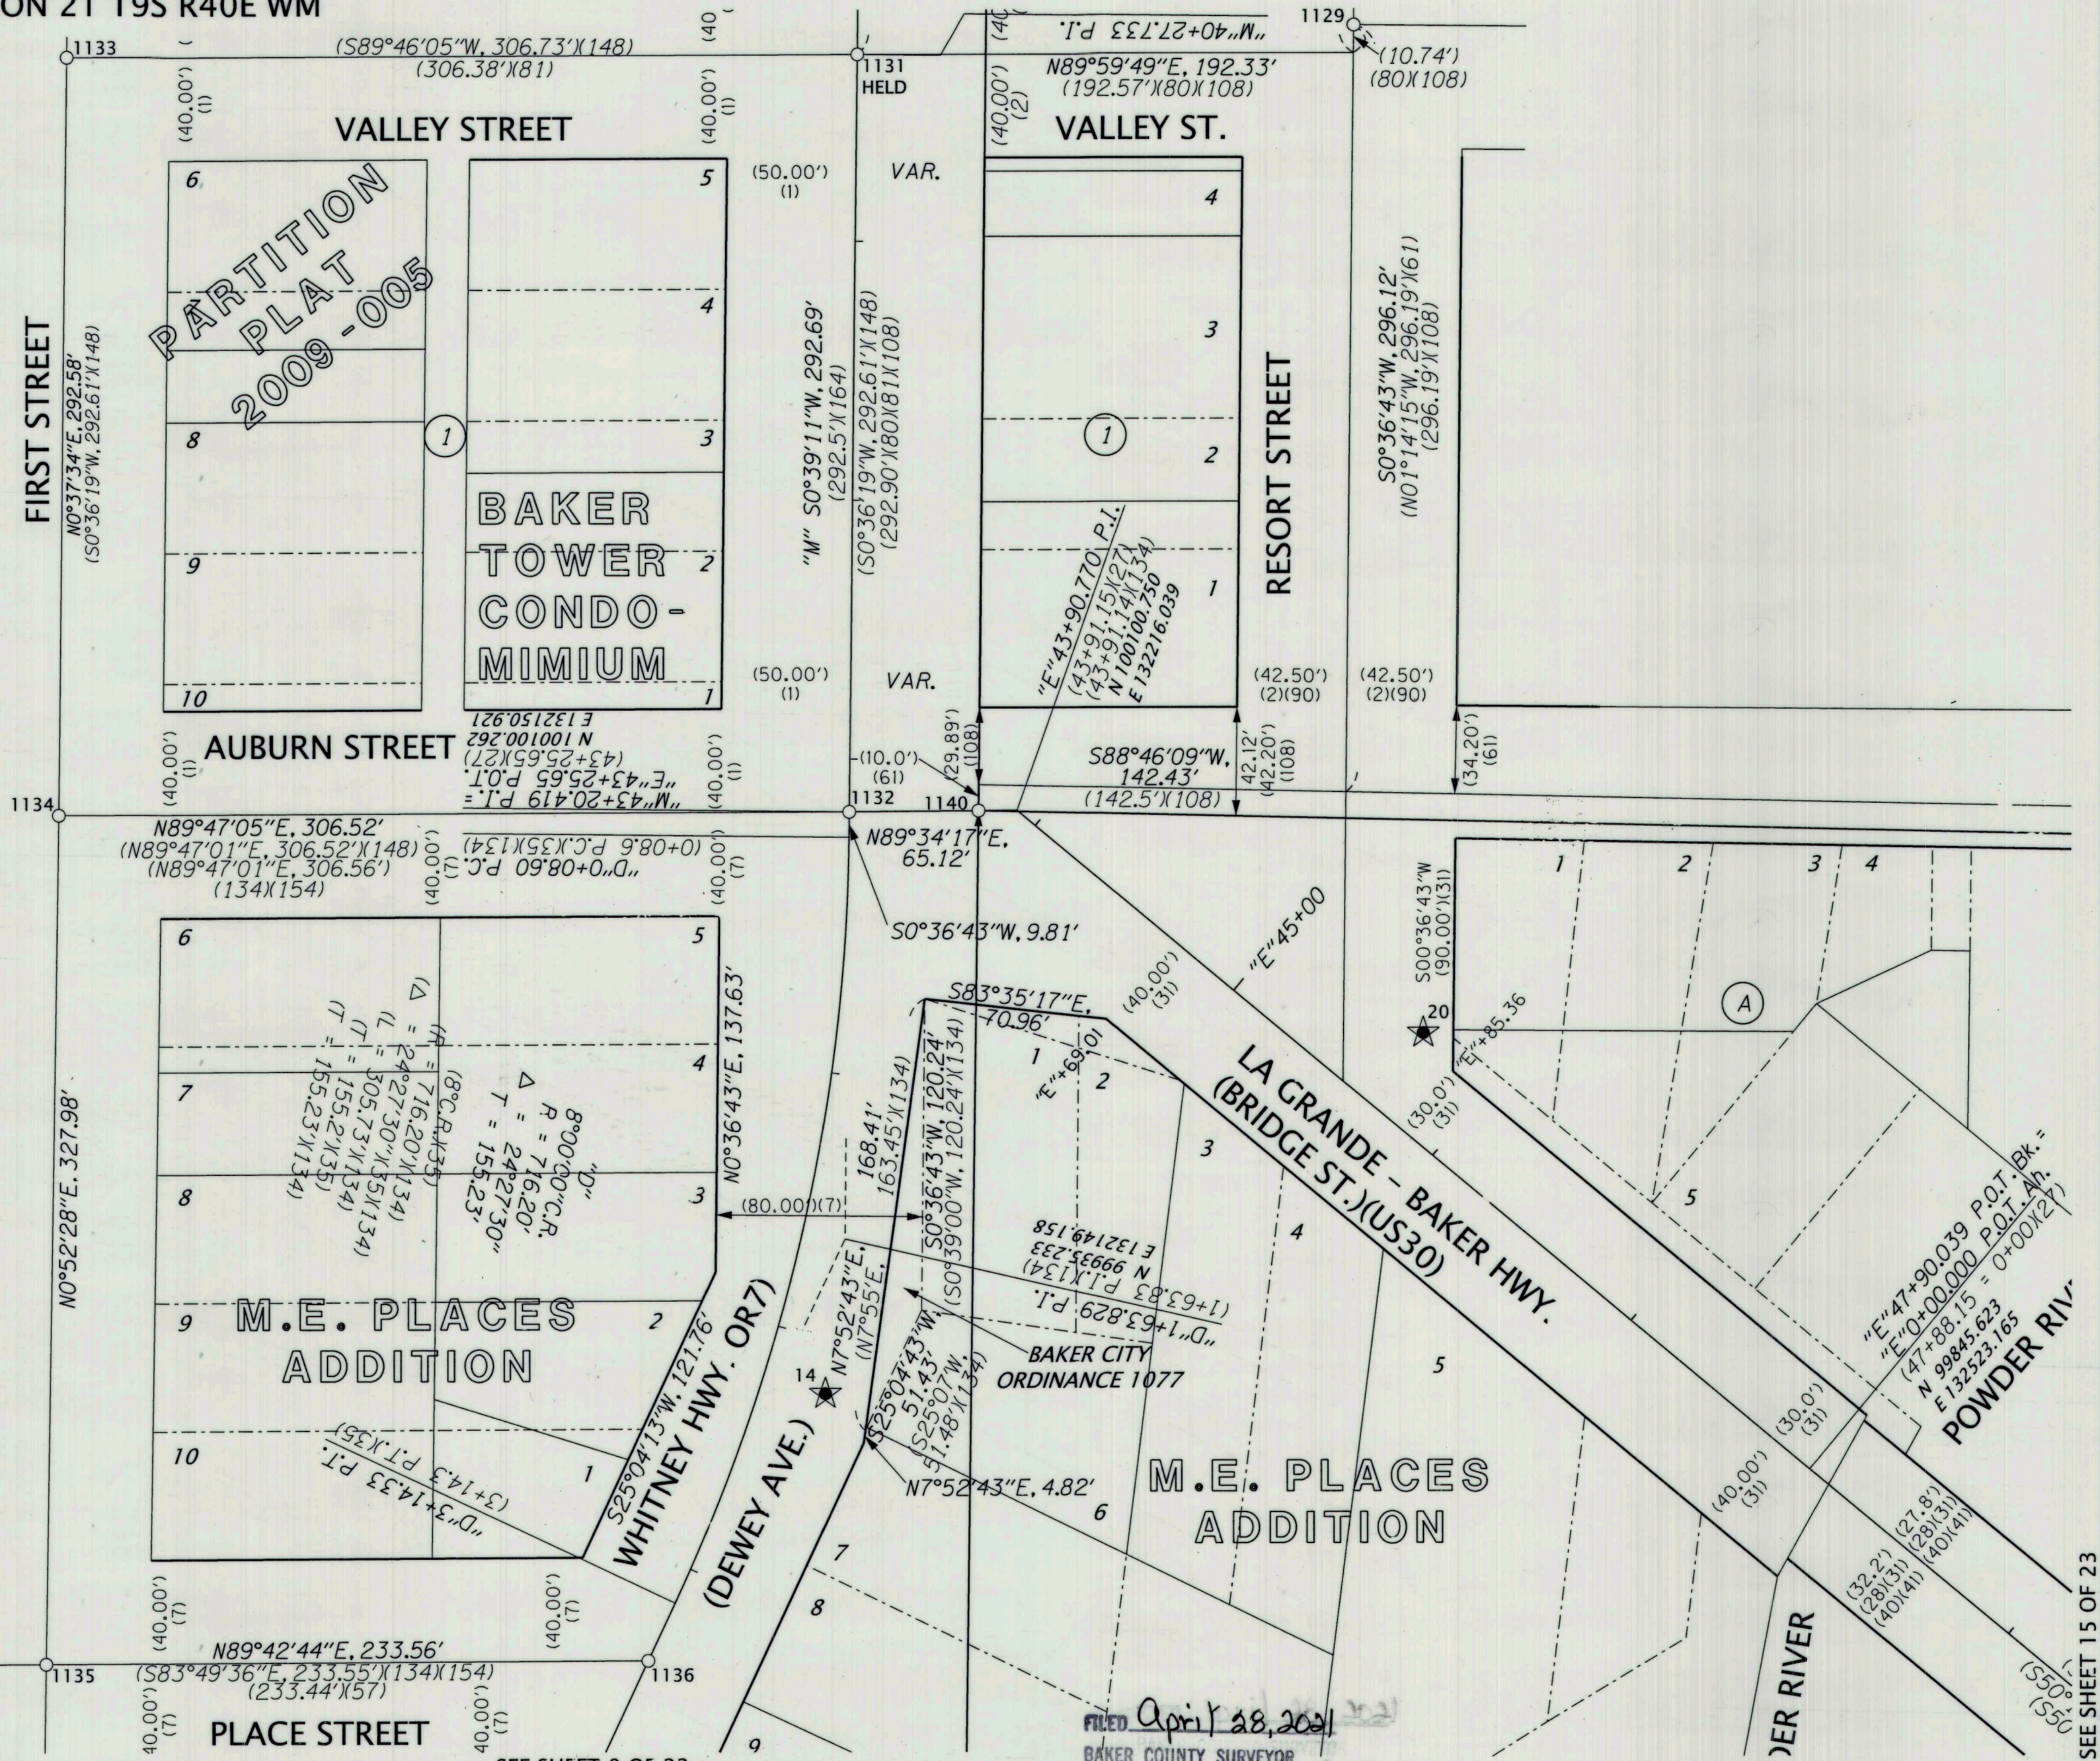

RECOVERED MONUMENT LIST

PT ID	NORTHING	EASTING	STATION	OFFSET	DATE	DESCRIPTION & REFERENCE DOCUMENTS	ALUM. = ALUMINUM FD = FOUND MON. = MONUMENT	SN = SURVEY NUMBER W/ = WITH YPC = YELLOW PLASTIC CAP
1129	100403.68	132346.70	N/A	N/A	2/19/20	FD 5/8" IRON ROD W/ 1-1/2" ALUM. CAP, ILLEGIBLE, IN MON. BOX, SN 09-40-0717		
1131	100392.93	132154.26	"M"40+27.73	0.00' RT	2/19/20	FD 5/8" IRON ROD W/ YPC MARKED "CITY OF BAKER PLS 2162", IN MON. BOX, SN 09-40-0272		
1132	100100.26	132150.92	"M"43+20.42	0.00' RT	2/19/20	FD 5/8" IRON ROD W/ YPC MARKED "CITY OF BAKER PLS 2162", IN MON. BOX, SN 09-40-0293		
1133	100391.67	131847.60	N/A	N/A	2/19/20	FD 2" BRASS CAP, NO MARKINGS FOUND, IN MON. BOX, UNKNOWN ORIGIN, FD ON SN 09-40-0137BC		
1134	100099.11	131844.41	N/A	N/A	2/19/20	FD 5/8" IRON ROD W/ YPC MARKED "CITY OF BAKER PLS 2246", IN MON. BOX, SN 09-40-0762A		
1135	99771.17	131839.40	N/A	N/A	2/19/20	FD 5/8" IRON ROD IN MON. BOX, ORIGIN UNKNOWN, FD ON SN 09-40-0550		
1136	99772.34	132072.96	"D"3+38.94	0.00' RT	2/19/20	FD 5/8" IRON ROD W/ 1-1/2" ALUM. CAP, "OREGON DEPT. TRANS.", IN MON. BOX, SN 09-40-0738		
1140	100100.64	132201.04	"E"43+75.77	0.00' RT	2/19/20	FD 5/8" IRON ROD IN MON. BOX, SN 09-40-0293		
1255	99769.53	131542.77	N/A	N/A	5/12/20	FD 5/8" IRON ROD IN MON. BOX, UNKNOWN ORIGIN, FD ON SN 09-40-0550		

FILED April 28, 2021
 BAKER COUNTY SURVEYOR
 SURVEY NO. 9-40-823

REGISTERED PROFESSIONAL LAND SURVEYOR

 OREGON
 JAN. 14, 2003
 BRET N. ELITHORP
 63148
 EXPIRES: 12-31-2021

OREGON DEPARTMENT OF TRANSPORTATION
 HORIZONTAL CONTROL, RECOVERY AND RETRACEMENT MAP
 BAKER-COPPERFIELD HWY. (OR7)(MAIN ST.) : CAMPBELL TO BROADWAY
 LA GRANDE-BAKER HWY. (US30): 10TH TO S. BRIDGE ST.
 WHITNEY HWY. (DEWEY ST.): AUBURN TO INDIANA
 BAKER COUNTY

ODOT REGION 5 TECH CENTER
 3012 ISLAND AVENUE
 LA GRANDE, OR 97850
 KEY NO. 21494

APRIL 27, 2021
 SCALE: 1"=50'
 SHEET 8 OF 23