


CERTIFIED RECORD OF LAND CORNER MONUMENTATION

HISTORY OF ORIGINAL CORNER ESTABLISHMENT:

THIS CORNER WAS ORIGINALLY ESTABLISHED BY DAVID P. THOMPSON AND DANIEL CHAPLIN UNDER CONTRACT NO. 104 DATED MAY 18, 1864.

SURVEYOR GENERAL LAND OFFICE RECORDS STATE:  
"SET POST FOR 1/4 SEC. CORNER IN MOUND OF EARTH  
WITH A CHARRED STAKE, PITS TRENCH 8' AS PER INSTRUCTIONS"

SURVEY NUMBER 09-40-0785 SHOWS THE IRON PIPE MONUMENT  
COMING FROM A UNRECORDED SURVEY BY PHILO ANDERSON  
DATED SEPTEMBER 24, 1947, ACCEPTED AT THIS CORNER

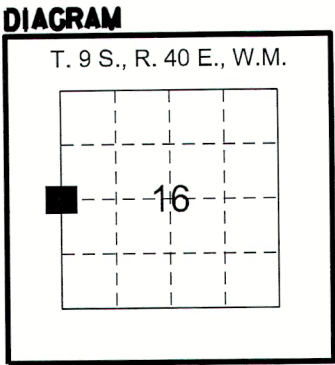

DESCRIPTION OF CORNER EVIDENCE FOUND:

HELD COORDINATES FROM SURVEY NUMBER 9-40-823, POINT 1118.  
POINT BEING A 3" IRON PIPE WITH CAP IN MONUMENT BOX.


DESCRIPTION OF MONUMENT AND ACCESSORIES I ESTABLISHED TO  
PERPETUATE THE ORIGINAL LOCATION OF THIS CORNER:

SET 2-1/2" BRASS CAP ON A 5/8" X 30" IRON ROD, FLUSH WITH SIDEWALK

THE CAP IS MARKED AS SHOWN BELOW.

THE REFERENCES SET FOR SAID CORNER ARE AS FOLLOWS:

- 1) A 5/8" X 30" IRON ROD WITH 1-1/2" ALUMINUM CAP, FLUSH, STAMPED "ODOT 100 2004"  
BEARS N51°22'17"E, 110.63 FEET.
- 2) A 1-1/8" COPPER DISK, FLUSH, STAMPED "ODOT"  
BEARS N68°16'31"W, 11.09 FEET.
- 3) A 5/8" X 7-1/2" IRON ROD WITH 1-1/2" ALUMINUM CAP, FLUSH, STAMPED "ODOT"  
BEARS S28°38'09"W, 9.30 FEET.
- 4) A 1-1/8" COPPER DISK, FLUSH, STAMPED "ODOT"  
BEARS S43°29'05"W, 10.54 FEET.

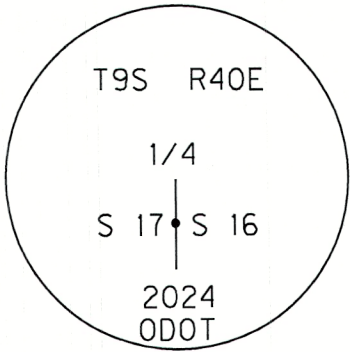

WITNESSES:  
MARK STEWART, LSIT

I HEREBY CERTIFY THAT THE ABOVE CORNER POSITION WAS  
RE-ESTABLISHED AS HEREON DESCRIBED ON MARCH 21, 2024.

REGISTERED  
PROFESSIONAL  
LAND SURVEYOR

*Cody A. Wheeler*

OREGON  
SEPTEMBER 08, 2020  
CODY A. WHEELER  
87585

RENEWS: 06/30/2024

OREGON DEPARTMENT OF TRANSPORTATION



RIGHT OF WAY  
ENGINEERING

FILED *April 10, 2024*

BAKER COUNTY SURVEYOR

SURVEY NO. *9-40-858, B*

|         |                                        |       |                |
|---------|----------------------------------------|-------|----------------|
| Section | BAKER-COPPERFIELD HWY., AUBURN TO I-84 |       |                |
| Highway | BAKER-COPPERFIELD HIGHWAY (OR7)        |       |                |
| County  | BAKER                                  | Scale | NTS            |
| Purpose | ADA RAMP                               | Date  | APRIL 08, 2024 |