


SUBDIVISION OF THE CARNAHAN TRACT
SECTION 11, T9S, R45E WM.
BAKER COUNTY OREGON
Scale 1" = 400'

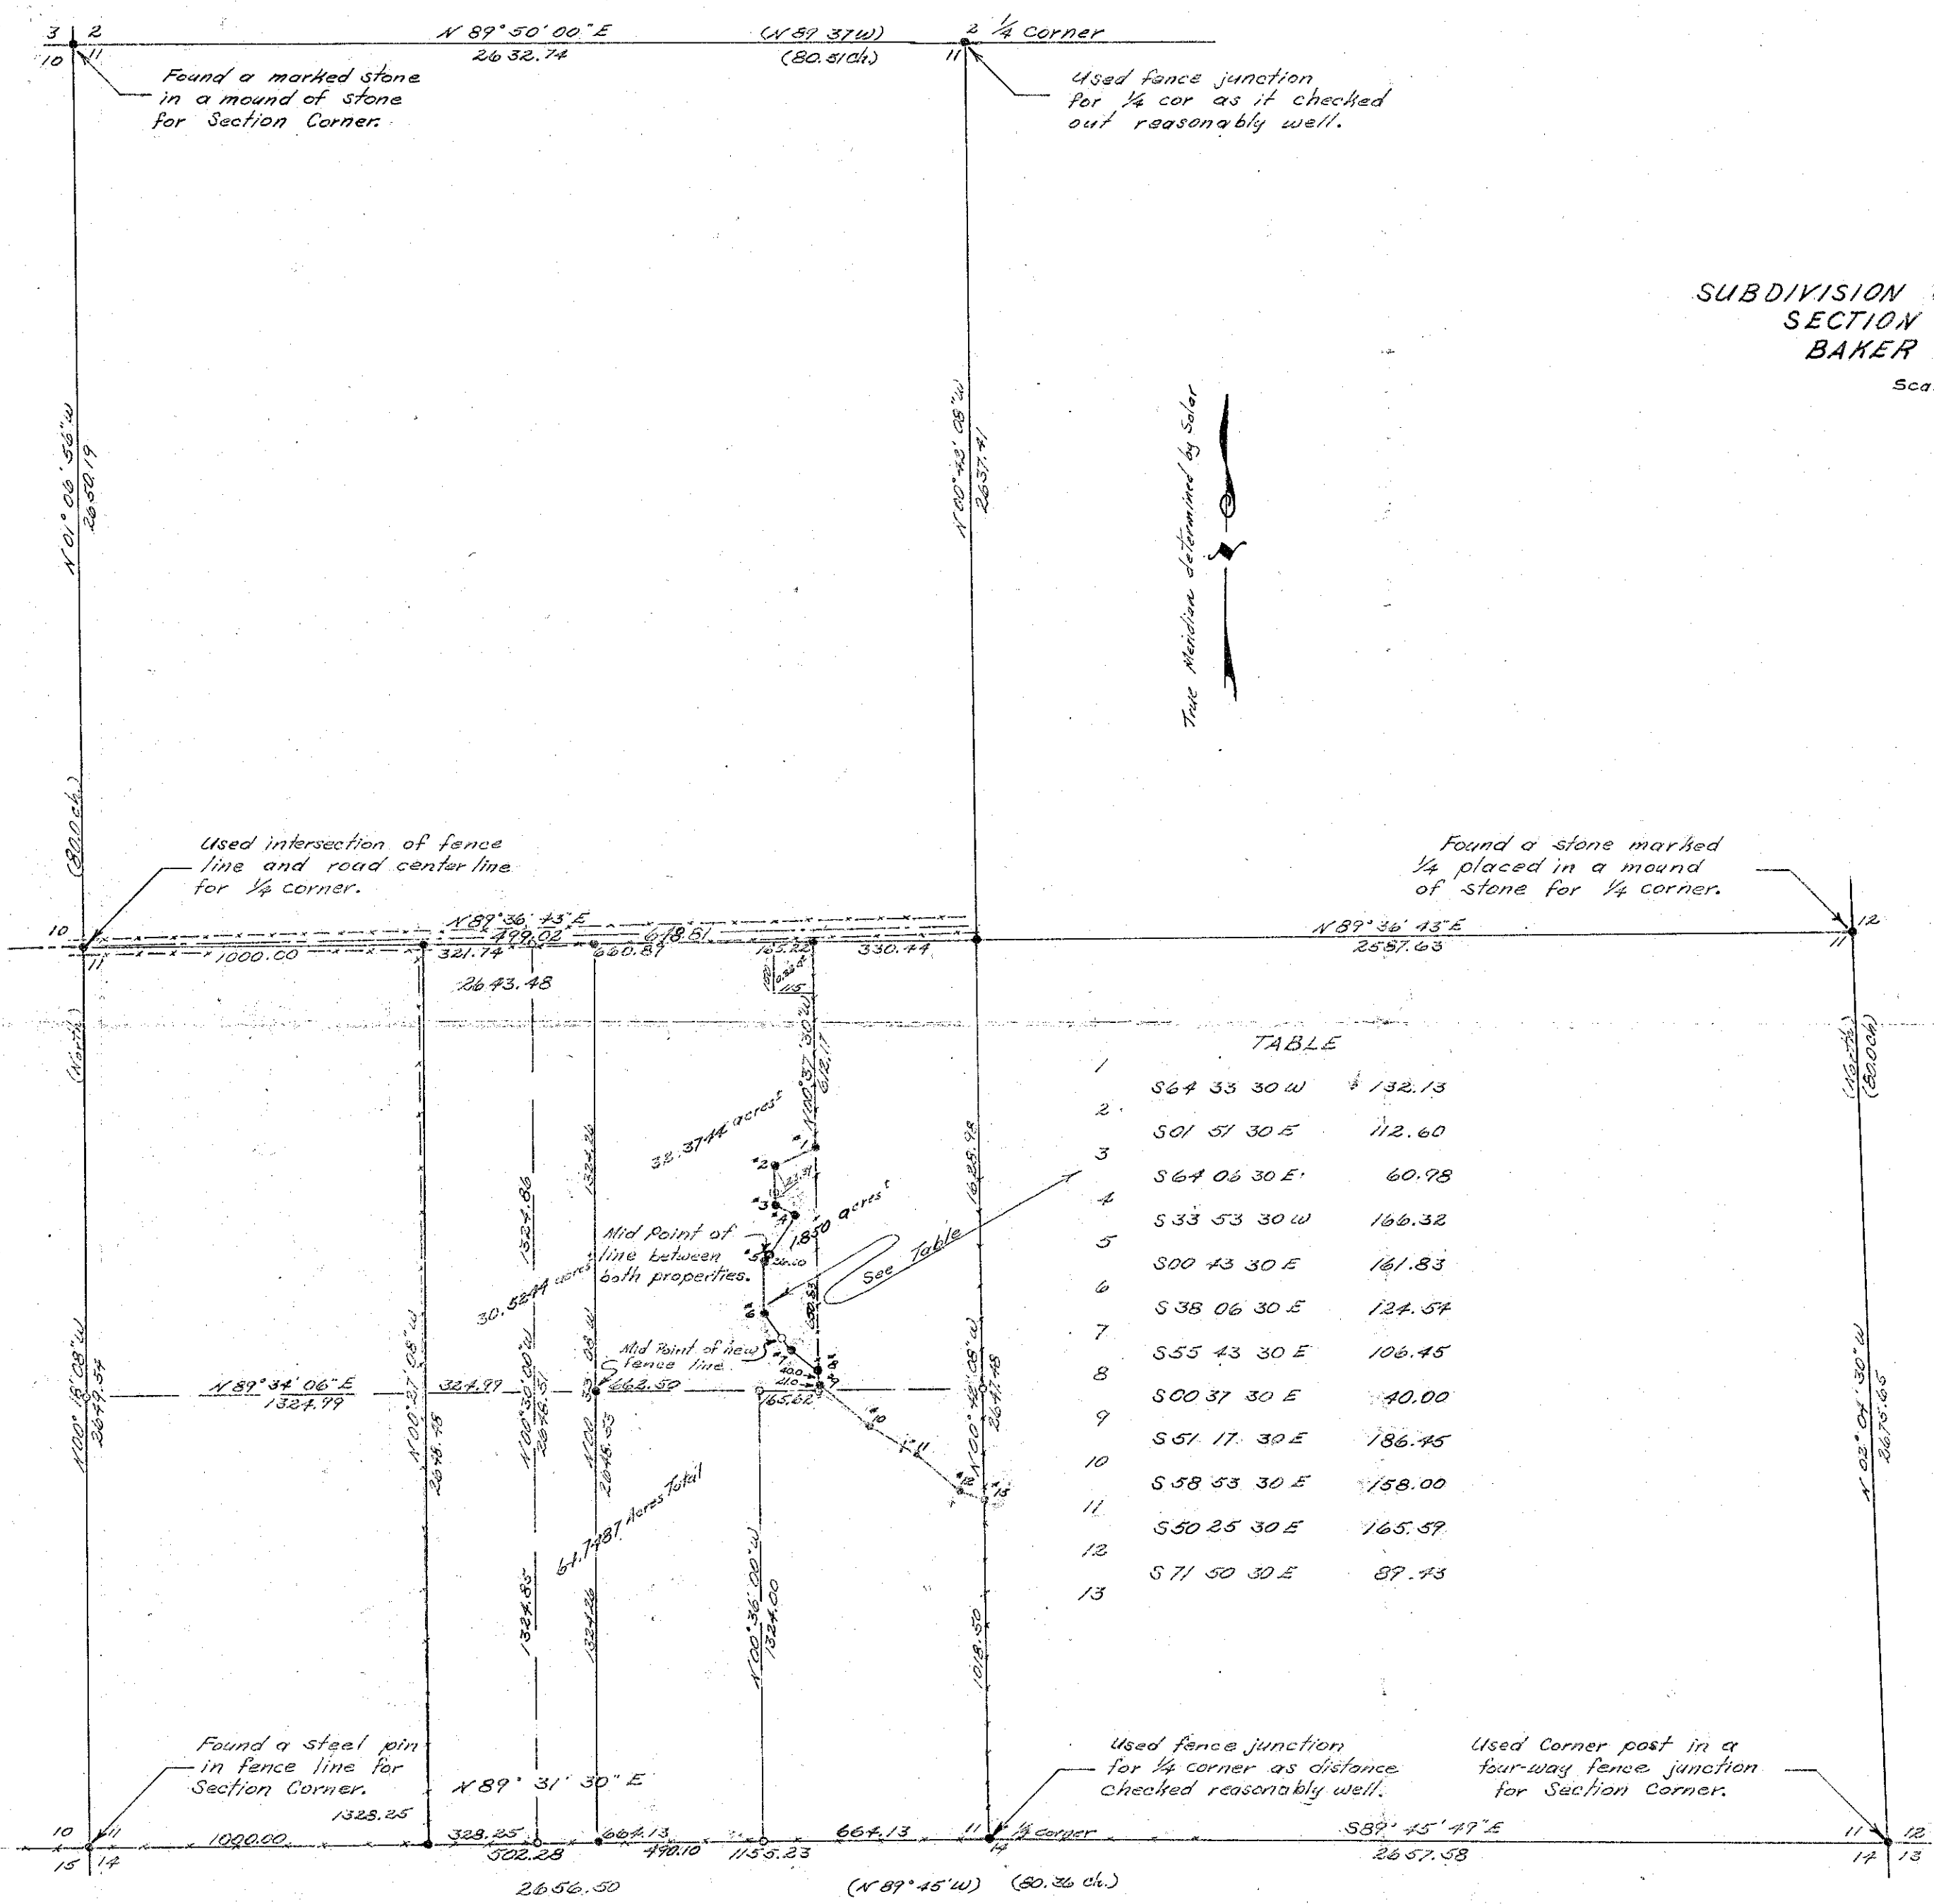

TABLE

1	S 64 33 30 W	132.13
2	S 01 51 30 E	112.60
3	S 64 06 30 E	60.98
4	S 33 53 30 W	166.32
5	S 00 43 30 E	161.83
6	S 38 06 30 E	124.57
7	S 55 43 30 E	106.45
8	S 00 37 30 E	40.00
9	S 51 17 30 E	186.45
10	S 58 53 30 E	158.00
11	S 50 25 30 E	165.59

FILED March 28, 1973
BAKER COUNTY SURVEYOR
SURVEY NO. 9-45-6

REGISTERED
OREGON
LAND SURVEYOR
JAMES H. HAMBLETON
11-12-59
JULY 10, 1934
JAMES H. HAMBLETON
645