


CERTIFIED RECORD OF LAND CORNER MONUMENTATION

History of original corner establishment:

Corner established by Survey No. 9-45-10 filed
September 12, 1974.

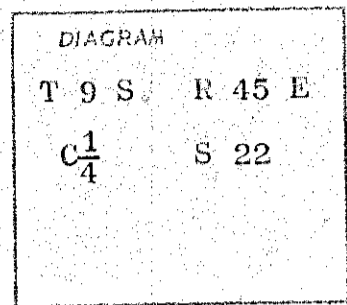

Description of corner evidence found:

Found none.

Description of monument and accessories established to perpetuate the
original location of this corner:

Set 2 inch aluminum cap on 1 inch post, 24 inches long, 18 inches in
the ground marked thus:

T 9 S R 45 E
 C $\frac{1}{4}$ S 22
 CS 1975

Office of Baker County Surveyor, County of Baker
 State of Oregon, I hereby certify that the within instrument was filed in this office
 for record on the _____ day of _____

(COUNTY OFFICIAL)

(DEPUTY)

FILED 3-3-75
 BAKER COUNTY SURVEYOR
 SURVEY NO. 9-45-13

