


CERTIFIED RECORD OF LAND CORNER MONUMENTATION

History of original corner establishment:

Corner established by W. B. Barr under contract dated June 14, 1880.

Surveyor's General record states:

Set stake 4 ft. long, 4 inches in diam., 18 inches in ground for 1/4 Sec. corner. Raised mound of rock as per instructions.

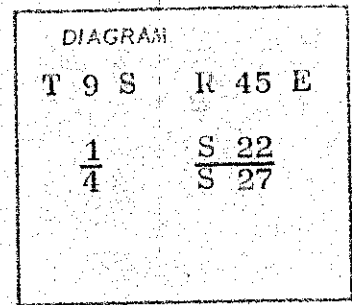

Description of corner evidence found:

None, corner established by proportionate measurement.

Description of monument and accessories established to perpetuate the original location of this corner

Set 1/2 inch rebar on the North edge of the state highway from which, the North right of way monument (Station 2065+73.41) bears N. 82° 20' 14" W., 264.96 ft.

Monument marked thus:

T 9 S	R 45 E
$\frac{1}{4}$	$\frac{S 22}{S 27}$
CS 1975	

Office of Baker County Surveyor, County of Baker, State of Oregon, I hereby certify that the within instrument was filed in this office for record on the _____ day of _____, _____ by _____ (COUNTY OFFICIAL) _____ (DEPUTY)

FILED 3-3-75
 BAKER COUNTY SURVEYOR
 SURVEY NO. 9-45-14

