


CERTIFIED RECORD OF LAND CORNER MONUMENTATION

History of original corner establishment:

Corner established by W. B. Barr under GLO contract no. 355 dated June 14, 1880.

Surveyor's General records state:

Marked basalt rock 14 x 8 x 5 for corner to Secs 17, 18, 19 and 20. Raised mound of rock as per instructions.

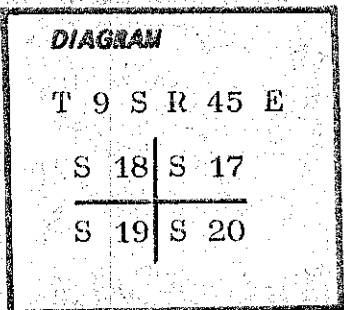

Description of corner evidence found:


Original corner stone not found.

Found an ancient fence corner at proper location of corner.

Description of monument and accessories I established to perpetuate the original location of this corner:

Set a 2½ inch brass cap on a 1 inch iron pipe and projecting 8 inches out of the ground.

Brass cap marked thus: T 9 S R 45 E

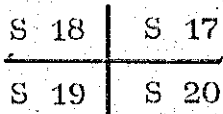

CS 1980

No accessories were established to brass cap monument.

I hereby certify that the above corner monument was properly re-established under my direct supervision on April 8, 1980, and witnessed by Brad Gordon, Tom Fisk and Jim DeMastus.

REGISTERED
PROFESSIONAL
LAND SURVEYOR

William L. Hanley

OREGON
JULY 14, 1978
WILLIAM L. HANLEY
1639

Office of..... County Surveyor..... Baker
 State of Oregon..... I hereby certify that the within instrument was filed in this office
 for record on the 7 day of May..... 1980
James D. Hanley..... by William L. Hanley
 (COUNTY OFFICIAL)..... (DEPUTY)