


CERTIFIED RECORD OF LAND CORNER MONUMENTATION

History of original corner establishment:

Corner was originally established by N. Walden under GLO contract number 198 dated July 15, 1873

Surveyor General record states;

Set granite rock 12x8x6 8 in in ground for 1/4 Sec Cor

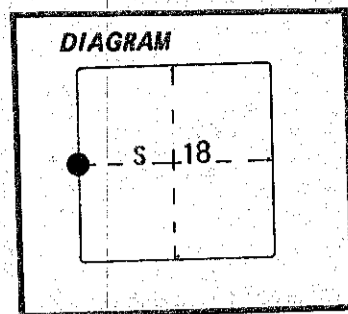

Description of corner evidence found:

Found well marked basalt stone, call size alongside fence corner


Description of monument and accessories I established to perpetuate the original location of this corner:

At the position of the stone, I set a 1 1/2" x 36" iron pipe with brass cap marked as shown, 30 inches in the ground

Buried stone west and alongside of pipe

No corner accessories available

I accepted the stone because of the marking, its size, and harmony with the position established by survey number 9-45-20

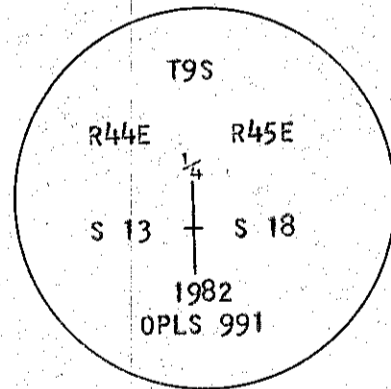

REGISTERED PROFESSIONAL LAND SURVEYOR

Gregory T. Blackman

OREGON JULY 13, 1973 GREGORY T. BLACKMAN 991

Office of..... County of.....
State of..... I hereby certify that the within instrument was filed in this office
for record on the..... day of....., 19.....
..... by
(COUNTY OFFICIAL) (DEPUTY)

Form R6-7100-57 (9/71)

FILED APRIL 28, 1982
BAKER COUNTY SURVEYOR
SURVEY NO. 9-45-29