

CERTIFIED RECORD OF LAND CORNER MONUMENTATION

History of original corner establishment:

Corner established by W. B. Barr under GLO contract no 355 dated June 14, 1880.


Surveyor General records state:

Set stake 4 ft long 4 ins diam in mound of rock dug pits as per instructions for corner to Sec 22x23x26x27



Description of corner evidence found:

The original corner established by Barr has been destroyed by highway construction. Corner position reestablished at point of intersection of highway right of way fences with North running fence line which is locally accepted as section line between sections 22 and 23. See sketch.

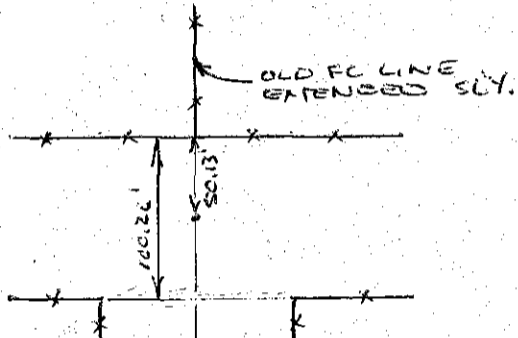

Description of monument and accessories established to perpetuate the original location of this corner:

At the above described corner position, set a 3/8 inch diameter rebar flush with pavement surface.

I hereby certify that the above described corner monument was properly established under my supervision and witnessed by Brad Gordon, Tom Fisk and Jim DeMastus.

REGISTERED
PROFESSIONAL
LAND SURVEYOR
James D. Hanley
OREGON
SEPTEMBER 23, 1977
JAMES D. HANLEY
1206

Office of..... County of.....
State of....., I hereby certify that the within instrument was filed in this office
for record on the..... day of....., 19.....
..... by
(COUNTY OFFICIAL) (DEPUTY)

Form R6-7100-51 (9/71)

FILED JULY 6, 1982
BAKER COUNTY SURVEYOR
SURVEY NO. S-45-33