

CERTIFIED RECORD OF LAND CORNER MONUMENTATION


History of original corner establishment:

Corner established by W. B. Barr under GLO contract no. 355 dated June 14, 1880.

Surveyor General records state:

Set stake 4 ft long 4 ins diam 18 ins in ground for 1/4 sec cor from which;

Cottonwood 10 ins diam bears S 45° W, 181 lks dist
No other trees

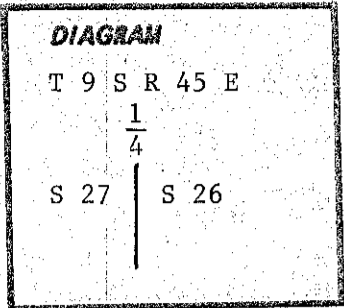

Description of corner evidence found:

At approximate corner location found a stone marked 1/4 in place at base of fence corner from which the fence lines bear North, East and West.

It appears that this stone has been marked in a professional manner and is presumed that the original wood post corner monument has been remonumented by competent authority with no remonumentation record filed.


Description of monument and accessories established to perpetuate the original location of this corner:

Set a 2 1/2 inch brass cap on a 1 inch iron pipe 31 inches long and projection 6 inches out of the ground with a surrounding rock mound. Buried marked stone alongside.

Brass cap marked thus:

	T 9 S R 45 E	
	1/4	
S 27		S 26
	CS 1982	

I hereby certify that the above described corner monument was properly established under my supervision and witnessed by Brad Gordon, Jim DeMastus and Tom Fisk.

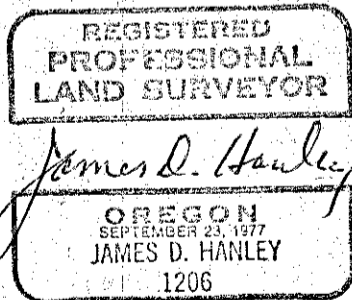

Office of..... County of.....
 State of....., I hereby certify that the within instrument was filed in this office
 for record on the..... day of....., 19.....
 by
 (COUNTY OFFICIAL) (DEPUTY)

Form R6-7100-5/ (9/71)

FILED JULY 6, 1982
 BAKER COUNTY SURVEYOR
 SURVEY NO. 9-45-34