

RENEWAL

Monument Set (Procedure and Description)

Monument Detail

NONE


N/A

New Accessories

SEE BELOW

Sketch of Monument, Accessories, and General Area

Find. Original Stone with 2 NOTCHES ON East & 3 NOTCHES ON South in large mound of stones.

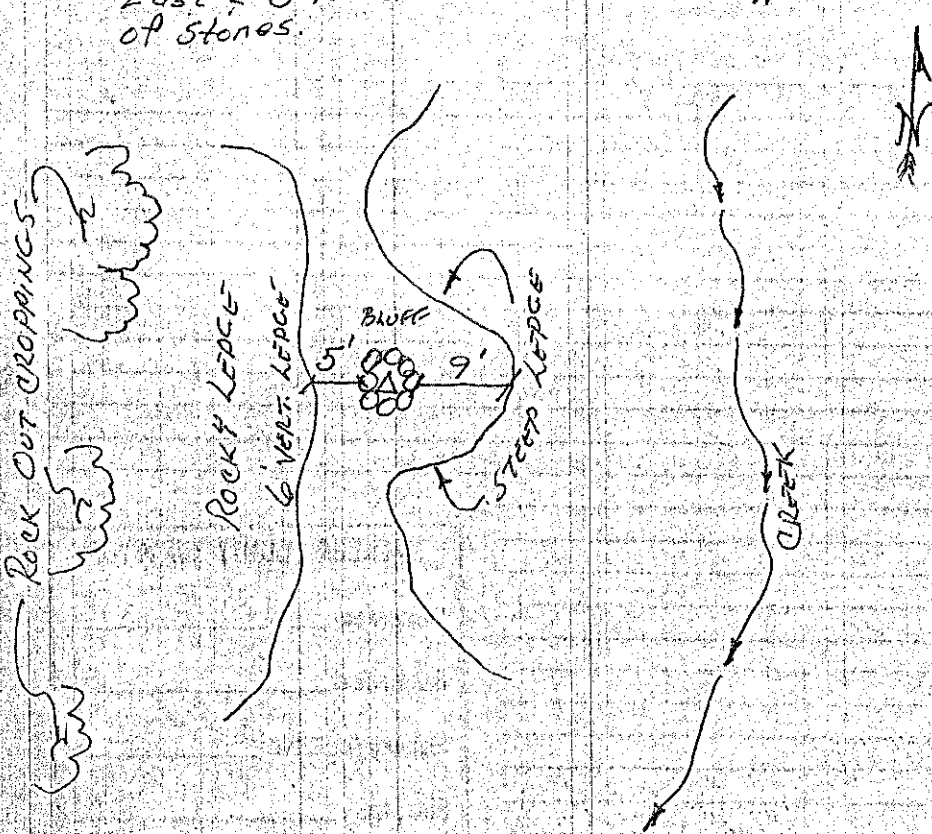

Location & Comments

ON Small Rocky BLUFF ON East Facing Slope

Comp. Declin.
 Agency GASCHLER & CUMMINGS
 Party Chief DAN K. CUMMINGS
 Notekeeper BOB RIGGINS
 Witnesses BOB RIGGINS

Surveyor's Seal

REGISTERED
 PROFESSIONAL
 LAND SURVEYOR

Danny K. Cummings
 8-5-92

OREGON
 JAN. 21, 1988
 DANNY K. CUMMINGS
 2316