RENEWAL

Monument Set (Procedure and Description)

NONE

Monument Detail

N/A

New Accessories

SEE BELOW

Sketch of Monument, Acessories, and General Area

FOUND 1½" IRON ROD @
SE COR. SEC. 10, T9S., R45E.

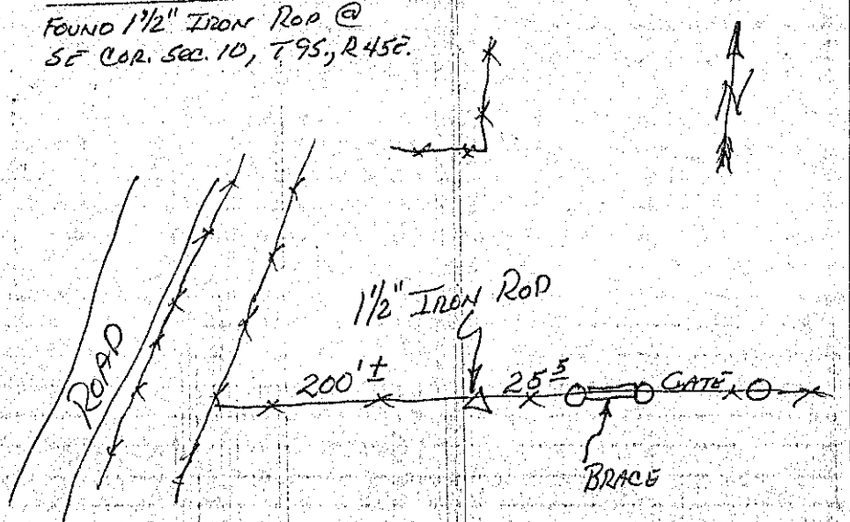

Location & Comments

IN East-West Fence Line
Appox. 200' East of Road

Comp. Declin.
Agency GASCHLER & CUMMINGS
Party Chief DAN K. CUMMINGS
Notekeeper Bob Riggins
Witnessed Bob Riggins

Surveyor's Seal

REGISTERED
PROFESSIONAL
LAND SURVEYOR

Dan Cummings
8-5-92

OREGON
JAN. 21, 1988
DANNY K. CUMMINGS
2315