

CERTIFIED RECORD OF LAND CORNER MONUMENTATION

DIAGRAM

History of original corner establishment:

The original corner was set by W.B. Barr, U.S. Deputy Surveyor, under Contract No. 335, dated June 14, 1880.

The original notes state:


Marked quartz rock 18 x 6 x 5 for 1/4 Sec. Corner. Raised mound of rock as per instructions.

Baker County Survey No. 9-45-21 states:

Found 18" x 7" x 5" marked stone for quarter corner.

Baker County Survey No. 9-45-62 states:

Found 18" x 7" x 5" marked stone. Set 12" spike.

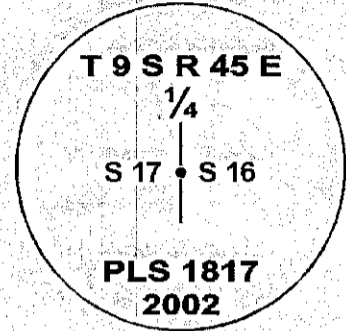

Description of corner evidence found:

Found 12" spike set under 18" x 6" x 5" stone marked "1/4". Found stone is at remnants of what appears to a East-West-North fence intersection.

Description of monument and accessories I established to perpetuate the original location of the corner:

Set a 2 1/2" diameter brass cap on a 1" x 30" galvanized pipe. The cap is marked as shown in the corner diagram. Buried the stone 1' North of the brass cap monument, approximately 1' below ground surface.

Corner monument references:

From the corner monument:

A 5/8" x 30" rebar with orange plastic cap marked "REFERENCE MONUMENT" bears N. 15° 59' 50" E., 10.78', set approximately 8" below ground.

A 5/8" x 30" rebar with orange plastic cap marked "REFERENCE MONUMENT" bears S. 44° 04' 00" E., 6.95', set approximately 8" below ground.

A 5/8" x 30" rebar with orange plastic cap marked "REFERENCE MONUMENT" bears S. 36° 54' 25" W., 7.89', set approximately 8" below ground.

A 5/8" x 30" rebar with orange plastic cap marked "REFERENCE MONUMENT" bears N. 54° 04' 03" W., 8.63', set approximately 8" below ground.

Reference surveys and basis of bearing: Baker County Survey Numbers 9-45-21 and 9-45-62.

I, Thomas J. Hanley certify that this corner was properly reestablished as witnessed by Eric Stricker and Kirby Danford on March 11, 2002. Monument references were set on March 27, 2002.

FILED November 11, 2002
BAKER COUNTY SURVEYOR
SURVEY NO. 9-45-68
CORNER PRES. NO. CP #93

**REGISTERED
PROFESSIONAL
LAND SURVEYOR**

Thomas J. Hanley

OREGON
JULY 13, 1979
THOMAS J. HANLEY
1817

Renews June 30, 2003