


# RECORD OF LAND CORNER MONUMENTATION

Description of corner evidence found and history:

I found an old rotted off fence post that checked fairly closely with other surveys that had used this corner position, but only made the call to the corner post. It is difficult to know for certain where the corner position is that was used when no marker was set.

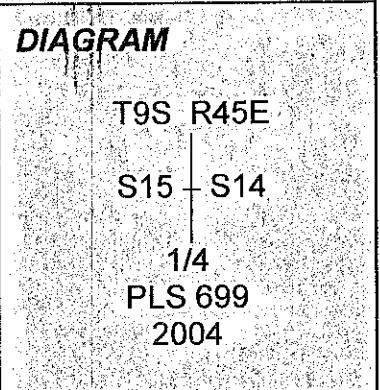


Description of monument and accessories I established to perpetuate the original location of this corner:

I set a 30" long 1" galvanize pipe with a 2 1/2" brass cap 28 " in the ground at the position of the old rotted off post and made ties to the following references:

- A magnetic DEEP with red ribbon set 16" in the ground bears N5°W, 12.9 feet;
- A magnetic DEEP with white ribbon set 18" in the ground bears S82°W, 11.4 feet;
- A magnetic DEEP with blue ribbon set 16" in the ground bears S4°W, 11.8 feet;
- and a No. 5 Rebar with a yellow plastic cap marked PLS 699 bears S89°17'35"E, 67.99 feet.

REGISTERED  
PROFESSIONAL  
LAND SURVEYOR

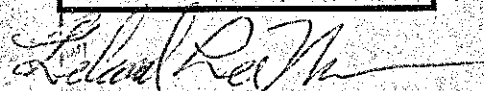

OREGON  
JULY 9, 1965  
LELAND LEE MYERS  
699

Renewal Date 1/1/2007

BAKER COUNTY SURVEYOR

RECEIVED FEBRUARY 14, 2005

ACCEPTED FEBRUARY 14, 2005

SURVEY No. 9-45-75

CP  
DWG. No. 111

INDEX No. T9S R45E L-17