
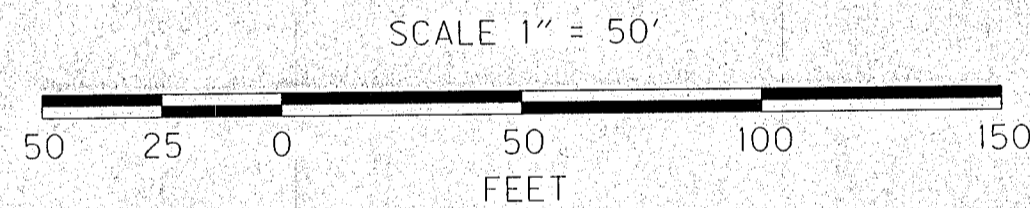


NE 1/4 SEC. 23, T. 9 S., R. 45 E., W.M.
 SE 1/4 SEC. 23, T. 9 S., R. 45 E., W.M.

SEE SHEET 1 FOR
 RECOVERED MONUMENT LIST

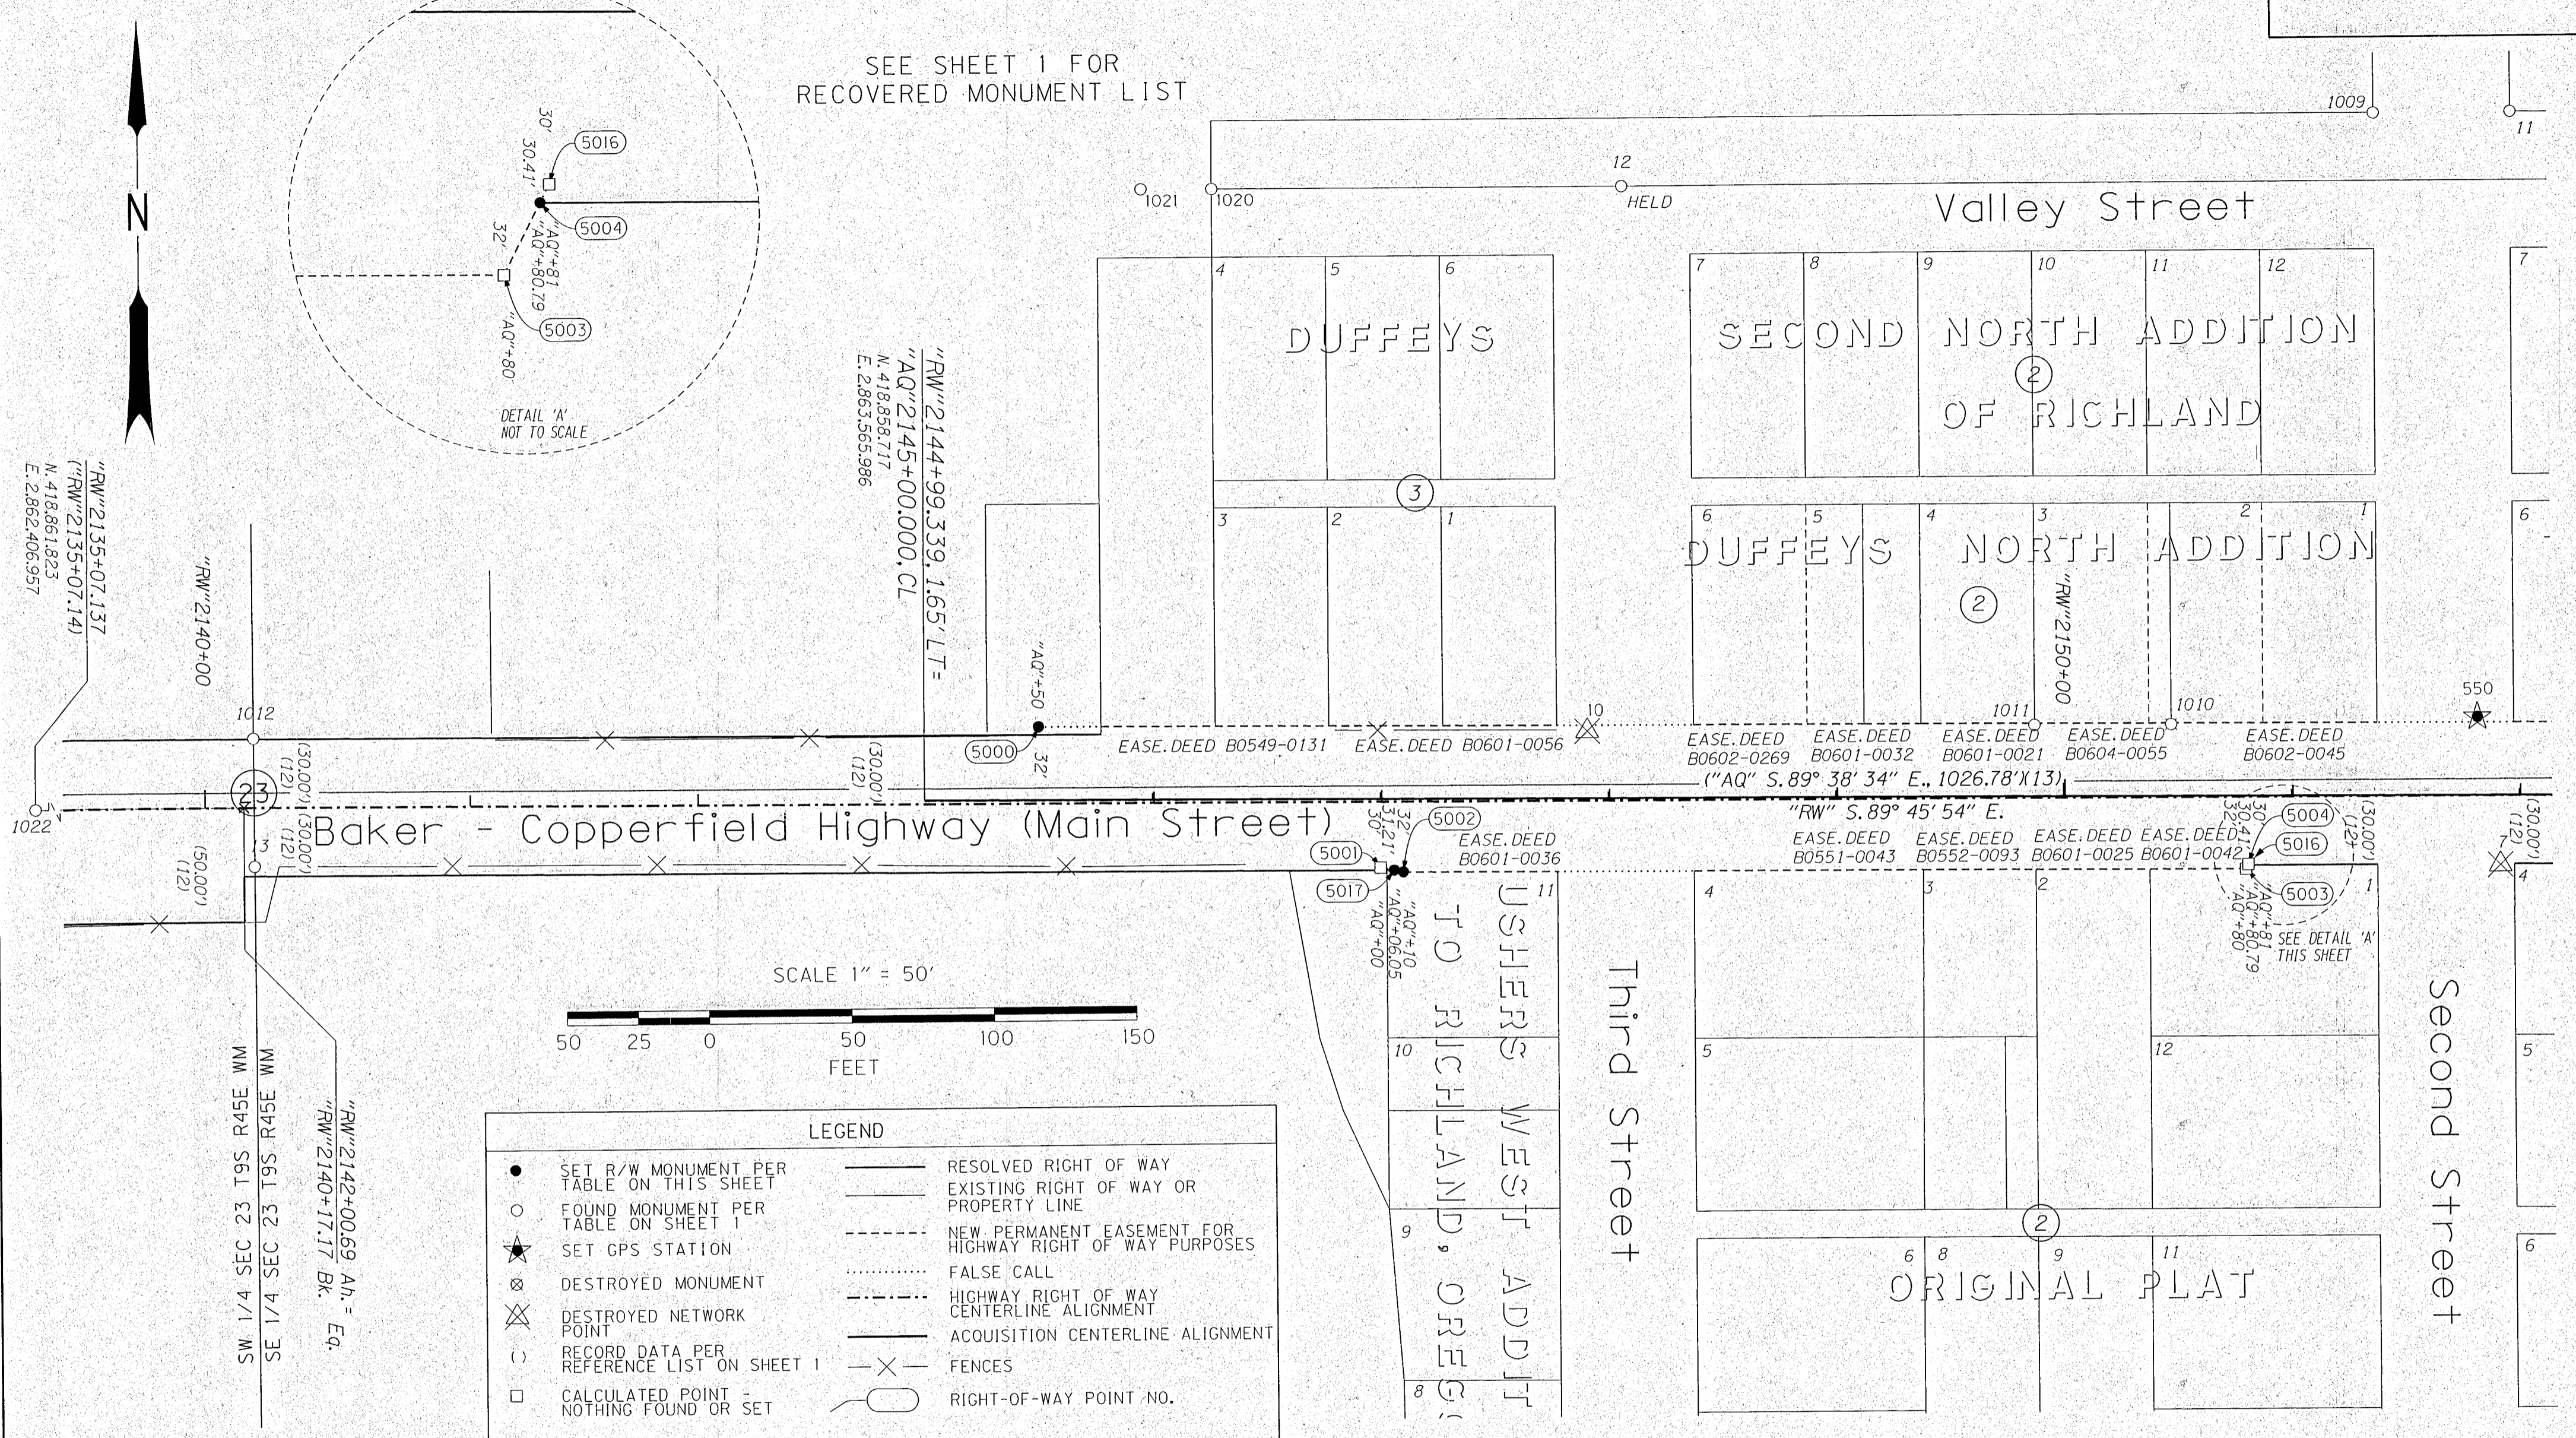

LEGEND			
●	SET R/W MONUMENT PER TABLE ON THIS SHEET	—	RESOLVED RIGHT OF WAY
○	FOUND MONUMENT PER TABLE ON SHEET 1	—	EXISTING RIGHT OF WAY OR PROPERTY LINE
★	SET GPS STATION	- - - -	NEW PERMANENT EASEMENT FOR HIGHWAY RIGHT OF WAY PURPOSES
⊗	DESTROYED MONUMENT	FALSE CALL
⊗	DESTROYED NETWORK POINT	- - - -	HIGHWAY RIGHT OF WAY CENTERLINE ALIGNMENT
()	RECORD DATA PER REFERENCE LIST ON SHEET 1	— X —	ACQUISITION CENTERLINE ALIGNMENT
□	CALCULATED POINT NOTHING FOUND OR SET	— X —	FENCES
		○	RIGHT-OF-WAY POINT NO.

SET MONUMENT LIST

PT ID	PROJECT NORTHING	PROJECT EASTING	STATION	OFFSET	DATE	DESCRIPTION
550	418888.76	2864247.89	"AQ" 2151+81.70	34.29' LT	5/28/2015	SET PK NAIL, ODOT CONTROL POINT
5000	418890.40	2863616.18	"AQ" 2145+50.00	32.00' RT	5/28/2015	SET 5/8"x30" IRON ROD W/ 1-1/2" ALUMINUM CAP MARKED "ODOT"
5001	418827.47	2863765.80	"AQ" 2147+00.00	30.00' LT	6/8/2015	SET 5/8"x30" IRON ROD W/ 1-1/2" ALUMINUM CAP MARKED "ODOT"
5002	418825.41	2863775.78	"AQ" 2147+10.00	32.00' RT	6/8/2015	SET 5/8"x30" IRON ROD W/ 1-1/2" ALUMINUM CAP MARKED "ODOT"
5003	418823.10	2864145.78	"AQ" 2150+80.00	32.00' RT	N/A	CALCULATED POINT - NOTHING FOUND OR SET
5004	418824.69	2864146.58	"AQ" 2150+80.79	30.41' RT	6/8/2015	SET 5/8"x30" IRON ROD W/ 1-1/2" ALUMINUM CAP MARKED "ODOT"
5016	418825.10	2864146.79	"AQ" 2150+81.00	30.00' RT	N/A	CALCULATED POINT - NOTHING FOUND OR SET
5017	418826.22	2863771.83	"AQ" 2147+06.05	31.21' RT	7/27/2015	SET 5/8"x30" IRON ROD W/ 1-1/2" ALUMINUM CAP MARKED "ODOT"

REGISTERED PROFESSIONAL LAND SURVEYOR

Bret N. Elithorp
 OREGON
 JAN. 14, 2003
 BRET N. ELITHORP
 63148
 RENEWAL: DEC. 31, 2015
 SIGNED: 10/21/15

OREGON DEPARTMENT OF TRANSPORTATION

OR 86 : RICHLAND CITY SECTION
 BAKER - COPPERFIELD HIGHWAY
 BAKER COUNTY

FOR ODOT REGION 5
 3012 ISLAND AVE
 LA GRANDE, OR 97850

FILED Oct 6, 2015
 BAKER COUNTY SURVEYOR
 SURVEY NO. 9-45-95

AUGUST 20, 2015
 SCALE: 1" = 50'
 SHEET 2 OF 4