

CERTIFIED RECORD OF LAND CORNER MONUMENTATION

HISTORY OF ORIGINAL CORNER ESTABLISHMENT:

Corner originally established by W.B. Barr in GLO Contract No. 355, dated June 14, 1880. Surveyor General record states:
Marked basalt rock, 15x15x5 for 1/4 Sec. Corner.
Raised mound of rock as per instructions.

In Survey 09-45-27, James Hanley finds no remaining evidence and establishes the position by proportion. No monument set.

T9 S R45 E R-11

	S 21		

DESCRIPTION OF CORNER EVIDENCE FOUND:

None. A proportionate position falls in the centerline of Dry Gulch Road at a midpoint between the East/West running right of way fences. There are no lines of possession extending to the North or South that can be relied on for a perpetuation of an original corner position.

DESCRIPTION OF MONUMENT AND ACCESSORIES I ESTABLISHED

TO PERPETUATE THE ORIGINAL LOCATION OF THIS CORNER:

At proportionate position, I set a 5/8" x 15" iron pin, drilled into rock, 21" in the ground, with 2" brass cap, marked as shown below, from which:



NEW BEARING OBJECTS:

- A 5/8" x 15" iron pin bears North 56°23' East, a distance of 26.96 feet, with 1 1/2" aluminum cap marked BGB SURVEY MARKER NE RP
- A 5/8" x 15" iron pin bears South 49°26' East, a distance of 23.14 feet, with 1 1/2" aluminum cap marked BGB SURVEY MARKER SE RP
- A 5/8" x 15" iron pin bears South 50°36' West, a distance of 25.53 feet, with 1 1/2" aluminum cap marked BGB SURVEY MARKER SW RP

A Power pole bears North 51°10' West, a distance of 45.13 feet, with tag marked 000899.

I hereby certify that the corner was perpetuated on April 24, 2024.

Corner falls in centerline of Dry Gulch Road.

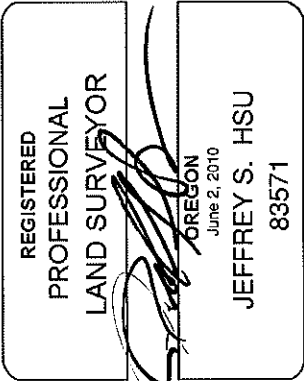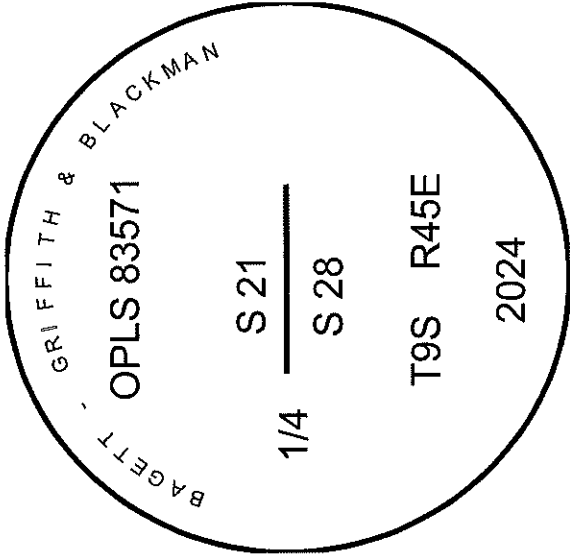

Renewal Date: June 30, 2025

I used a Leica GS18 GPS in the establishment of the accessories. Basis of Bearing is ORCS Halfway Zone. Bearing and distance to the aluminum caps are to the center of the aluminum caps. Bearing and distance to the power pole is to a washer marked OPLS 83571 set in the base of the pole on the SE side.

R-11

FILED May 1, 2024
BAKER COUNTY SURVEYOR
SURVEY NO. 9-45-113