


CERTIFIED RECORD OF LAND CORNER MONUMENTATION

History of original corner establishment:

Set a basalt stone 18 x 8 x 6 ins. 12 ins. in the ground for Cor. to Secs. 8, 9, 16, & 17 marked with 4 notches on S. & E. edges; from which
 A fir 36 ins. diam. bears N. 18° E. 93 lks. dist. marked T. 10 S. R. 35 E. S. 9 B.T.
 A fir 10 ins. diam. bears S. 80° E. 250 lks. dist. marked T. 10 S. R. 35 E. S. 16 B.T.
 A fir 40 ins. diam. bears S. 45° W. 37 lks dist. marked T. 10 S. R. 35 E. S. 17 B.T.
 A fir 14 ins. diam bears N. 45° W. 118 lks. dist. marked T. 10 S. R. 35 E. S. 8 B.T.

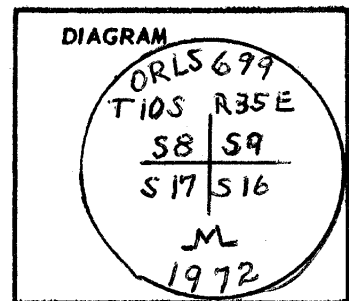


Description of corner evidence found:

Found the rock but could not find any markings. The rotted remains of the NW BT was found. No evidence of the SE BT could be found. The other two BT's were found standing with one of them dead.


Description of monument and accessories I established to perpetuate the original location of this corner

Set a 2" aluminum cap on a 1"x30" galvanized pipe, which is split for 8", on the east side of the rock. Attached Bearing Tree tags to the two BT's with the following information;

40" D. fir (Dead)	S36°W	26.0'
36" D. fir	N13°E	57.0'

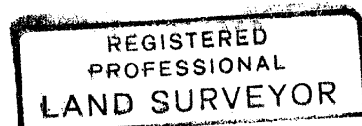

Leland Lee Myers

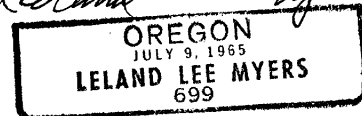

Office of County Surveyor County of Baker
 State of Oregon, I hereby certify that the within instrument was filed in this office
 for record on the 12 day of July, 1973, at 11 o'clock A.m., (signed)
 by Tom Hanley
 (COUNTY OFFICIAL) (DEPUTY)

SURVEY NO. 10-35-2