


CERTIFIED RECORD OF LAND CORNER MONUMENTATION

History of original corner establishment:

Set a quartz stone 14x8x5 ins. 9 ins. in the ground for
 $\frac{1}{4}$ Sec. Cor. marked $\frac{1}{4}$ on N. face,
 from which
 A fir 7" diam. bears N. 10° W. 30 lks. dist. marked $\frac{1}{4}$ BT
 A black pine 14" dia. brs. S. 55E. 25 lks. marked $\frac{1}{4}$ BT

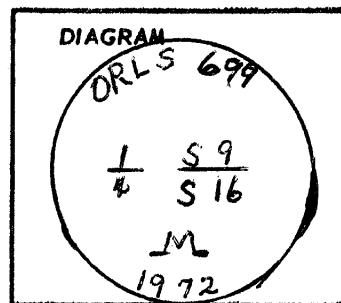


Description of corner evidence found:


Found the stone, but could not detect any chisel marks. The fallen and rotting remains of the N. BT was found with legible scribing. No evidence of the S. BT remained.

Description of monument and accessories I established to perpetuate the original location of this corner

Set a 2" aluminum cap on a 1"x30" galvanized pipe, which is split for 8", on the north side of the rock.

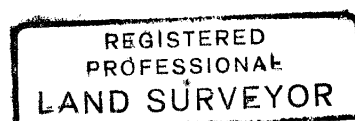

Leland Lee Myers

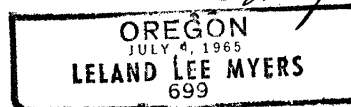

Office of County Surveyor County of Baker
State of Oregon, I hereby certify that the within instrument was filed in this office
for record on the 12 day of July, 1973, at 11 o'clock A.m., (signed)
Tom Hanley
(COUNTY OFFICIAL) by (DEPUTY)

SURVEY NO. 10-35-3