


CERTIFIED RECORD OF LAND CORNER MONUMENTATION

History of original corner establishment:

Set a quartz stone 20x12x8 ins. 15 ins. in the ground for $\frac{1}{4}$ sec. cor. marked $\frac{1}{4}$ on W. face; from which
 A tamarack 24 ins. diam. bears N. 10° E. 38 lks. dist. marked $\frac{1}{4}$ S., B.T.
 A fir 20 ins. diam. bears N. 30° E. 12 lks. dist. marked $\frac{1}{4}$ S., B.T.

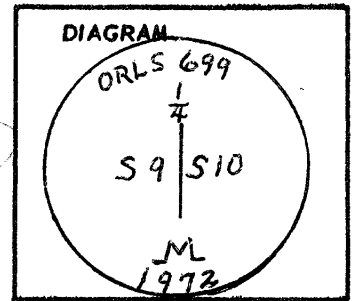

Description of corner evidence found:

The stone had been moved by wood cutters. The western larch BT is now a stump with the blaze and scribing still on it. The white fir BT has grown to 32" and has grown over the blaze and scribing.

Description of monument and accessories established to perpetuate the original location of this corner

Replaced the stone with the aid of the BT's and the hole from which the rock had been removed. Set a 2" aluminum cap on a 1"x30" galvanized pipe, which is split for 8", on the north side of the stone. Attached Bearing Tree tags to the BT's with the following information;

26" WL stump	N16°E	25.2'
32" WF	N29°W	7.0'

REGISTERED
PROFESSIONAL
LAND SURVEYOR

Leland Lee Myers

OREGON
JULY 9, 1965
LELAND LEE MYERS
699

Office of County Surveyor County of Baker
 State of Oregon, I hereby certify that the within instrument was filed in this office
 for record on the 19 day of July, 1973, at 11 o'clock A.m., (signed)
 _____ by Tom Hanley
 (COUNTY OFFICIAL) (DEPUTY)

SURVEY 10-35-5