


CERTIFIED RECORD OF LAND CORNER MONUMENTATION

History of original corner establishment:

On line 6-1 of the Golden Net Lode
A pine post 4 ft. long, 4" square, set 18" in the
ground, surrounded with a mound of earth, scribed
Clifton 1--554, from which
The $\frac{1}{4}$ Sec. Cor. on line between Sections 9 and 10,
T. 10 S., R. 35 E., W.M., bears S. $40^{\circ} 40'$ W. 17.0 ft.
blazed and scribed Clifton 1--554 B.T.

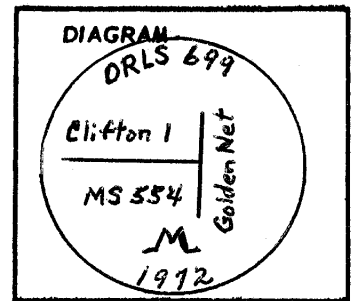


Description of corner evidence found:


The bearing tree and all other evidence of this corner had been obliterated, apparently by a forest fire many years ago.

Description of monument and accessories established to perpetuate the original location of this corner

This corner was re-established using the $\frac{1}{4}$ Section Corner tie and proportioning the original distances between corners. Set a 2" aluminum cap on a 1"x30" galvanized pipe, which is split for 8", for the corner.

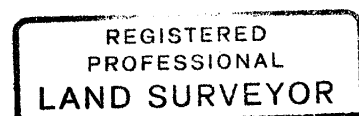

Leland Lee Myers

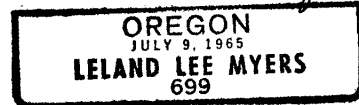

Office of County Surveyor County of Baker
State of Oregon, I hereby certify that the within instrument was filed in this office
for record on the 19 day of July, 1973, at 11 o'clock A.m., (signed)
..... by Tom Hanley
(COUNTY OFFICIAL) (DEPUTY)

SURVEY NO. 10-35-6