


CERTIFIED RECORD OF LAND CORNER MONUMENTATION

History of original corner establishment:

A fir post 4 ft. long, 4" square, set 18" in the ground with mound of stone, scribed E. 1—563, whence the $\frac{1}{4}$ Sec. Cor. on west boundary of Sec. 10 T. 10 S., R. 35 E., W. M., bears N. 17° 15' W. 659.44 ft.
 A black pine 4" diam. bears N. 42° 12' E. 36.75 ft.
 A black pine 8" diam. bears S. 10° 04' E. 16.06 ft.
 each blazed and scribed B.T. E. 1—563.

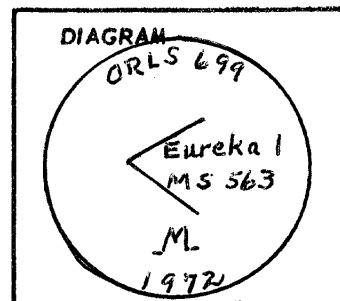

Description of corner evidence found:

The corner had been disturbed by what appeared to be a hunter making a campfire ring with the rocks from the mound. A portion of the original 4x4 post was found. The two lodgepole pine BT's have grown to be 8" and 12" respectively and are in fair condition.

Description of monument and accessories established to perpetuate the original location of this corner

With the aid of the BT's the corner was restored. Set a 2" aluminum cap on a 1"x30" galvanized pipe, which is split for 8", in the center of a rock mound about 2' in diameter and 1' high. Bearing Tree tags were attached to each BT with the information listed above for each tree. This corner is very near the proposed centerline of the Whitney-Greenhorn road and may be obliterated during construction if extreme care is not taken.

REGISTERED
PROFESSIONAL
LAND SURVEYOR

Leland Lee Myers

OREGON
JULY 9, 1965
LELAND LEE MYERS
699

Office of County Surveyor County of Baker
 State of Oregon, I hereby certify that the within instrument was filed in this office
 for record on the 19 day of July; 1973, at 11 o'clock A.m., (signed)
 _____ by Tom Hamley
 (COUNTY OFFICIAL) (DEPUTY)

FILED IN 10-35-9