


CERTIFIED RECORD OF LAND CORNER MONUMENTATION

History of original corner establishment:

A pine post 3½ ft. long, 4" square, set 18" in the ground, with mound of earth and stone, scribed E. 4-563, whence
A tamarack, 10" diam. bears S. 13° 10' E. 12.79 ft.
A tamarack 6" diam. bears S. 82° 52' W. 14.39 ft.
each blazed and scribed B.T. E. 4-563.

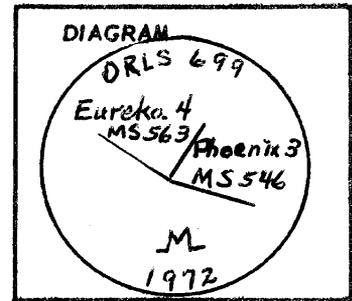

Description of corner evidence found:

Found a rock mound about 2' in diameter and 1' high in good condition. A portion of the original 4x4 corner post was found in the rock mound. The SE BT is now 12" in diameter and in good condition. The other BT is down and the scribing was clearly visible.

Description of monument and accessories established to perpetuate the original location of this corner

Set a 2" aluminum cap on a 1"x30" galvanized pipe, which is split for 8", in the center of the rock mound. Attached a Bering Tree tag to the standing BT with the information listed above for said tree.

REGISTERED
PROFESSIONAL
LAND SURVEYOR

Leland Lee Myers

OREGON
JULY 9, 1965
LELAND LEE MYERS
699

Office of County Surveyor County of Baker
State of Oregon, I hereby certify that the within instrument was filed in this office
for record on the 19 day of July; 1973, at 11 o'clock A.m., (signed)
..... by Tom Hanley
(COUNTY OFFICIAL) (DEPUTY)

CURTIS NO. 10-35-10