

CERTIFIED RECORD OF LAND CORNER MONUMENTATION

History of original corner establishment:


Identical with amended location Cor., also identical with Cor. No. 2 of the Phoenix Lode, and Cor. No. 6 of the Aerial lode, both of this survey.

A pine post 3 $\frac{1}{2}$ " long, 4" square, set 18" in the ground, with mound of earth and stone, scribed A-1-546. whence the $\frac{1}{4}$ Sec. Cor. on north boundary of Sec. 15 T. 10 S. R. 35 E. WM bears N. 65° 54' E. 650.1 ft.

A red fir, 24" diam. bears N. 53° 54' W. 78.00 ft.

A red fir, 30" diam. bears S. 53° 38' W. 66.00 ft.

Each blazed and scribed B.T. A. No.1-546


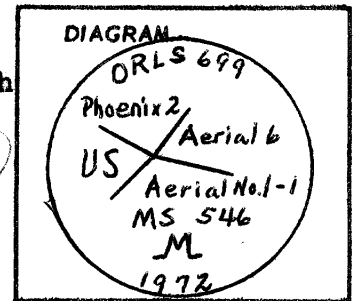


Description of corner evidence found:

Found a rock mound about 2' in diameter and 1' high in good condition with a portion of the original 4x4 corner post in the mound. Both BT's are standing, but the NW tree is a very rotten White Fir and the SW tree is a dead D. Fir.

Description of monument and accessories | established to perpetuate the original location of this corner

Set a 2" aluminum cap on a 1"x30" galvanized pipe, which is split for 8", in the center of the rock mound. A Bearing Tree tag was placed on each BT, the 36" white fir and the dead 30" D. fir, with the information listed above for each tree.

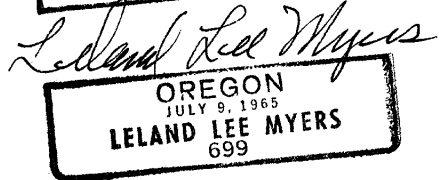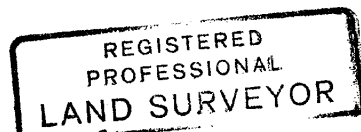

Office of County Surveyor County of Baker
State of Oregon, I hereby certify that the within instrument was filed in this office
for record on the 19 day of July, 1973, at 11 o'clock A.m., (signed)

(COUNTY OFFICIAL) by Tom Hanley
(DEPUTY)

INDEXED 10-35-11