


CERTIFIED RECORD OF LAND CORNER MONUMENTATION

History of original corner establishment:

A red fir post  $3\frac{1}{2}$ ' long, 4" square, set 18" in the ground with mound of stones, scribed A No. 1-4-546 when de  
A red fir 10" diam. bears N.  $74^{\circ} 45'$  W. 73.72 ft.  
A red fir 12" diam. bears S.  $53^{\circ} 15'E$ . 38.30 ft.  
Each blazed and scribed B.T. A. No. 1-4-546.

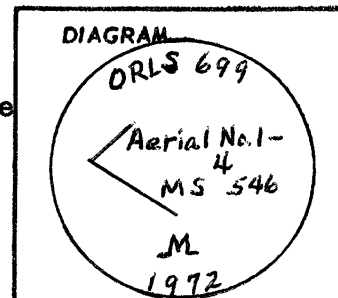

Description of corner evidence found:

Found a stone mound about 4' in diameter and 2' high with a portion of the original 4x4 post in the mound. The SE BT is dead and leaning against a rock outcropping. The other BT is in good condition.

Description of monument and accessories established to perpetuate the original location of this corner

Set a 2" aluminum cap on a 1"x30" galvanized pipe, which is split for 8", in the center of the rock mound. Placed a Bearing Tree tag on the NW BT which is a 16" D. fir with the information listed above for said tree. The line between corners 3 & 4 of this survey is impassable due to a high rock bluff.

REGISTERED  
PROFESSIONAL  
LAND SURVEYOR

*Leland Lee Myers*

OREGON  
JULY 9, 1965  
LELAND LEE MYERS  
699

Office of County Surveyor County of Baker  
State of Oregon, I hereby certify that the within instrument was filed in this office  
for record on the 19 day of July, 1973, at 11 o'clock A.m., (signed)  
..... by Tom Hanley  
(COUNTY OFFICIAL) (DEPUTY)