


CERTIFIED RECORD OF LAND CORNER MONUMENTATION

History of original corner establishment:

A black pine post, $3\frac{1}{2}$ ' long, 4" square, set 18" in the ground, with mound of rocks, scribed A. No. 1-3-546. whence, a tamarack stump 24" diam. bears S. 61° W. 24.79 ft. A black pine 6" diam. bears N. $20^{\circ} 15'$ W. 41.18 ft. Each blazed and scribed B.T. a. No. 1-3-546.

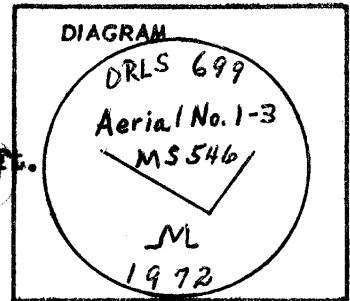


Description of corner evidence found:

Found a rock mound about 2' in diameter and 4" high in good condition. Both bearing references are in good condition. Also, Cor. No. 5 of the Confidence lode of this survey is N. 28° E. 10.6 ft.

Description of monument and accessories established to perpetuate the original location of this corner

Set a 2" aluminum cap on a 1"x30" galvanized pipe, which is split for 8", in the center of the rock mound. A Bearing Tree tag was placed on each reference with the information listed above for each. The lodgepole pine is now 10" in diameter.

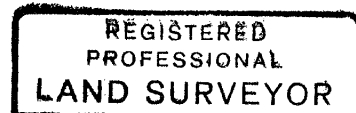

Office of County Surveyor County of Baker
State of Oregon, I hereby certify that the within instrument was filed in this office
for record on the 19 day of July, 1973, at 11 o'clock A.m., (signed)
by Tom Hanley
(COUNTY OFFICIAL) (DEPUTY)

CERT. NO. 10-35-14