


CERTIFIED RECORD OF LAND CORNER MONUMENTATION

History of original corner establishment:

Identical with amended location cor. also identical with Cor. No. 5 Aerial lode of this survey.
A Tamarack post, 4' long, 5" square, set 18" in the ground, with mound of rocks, scribed A-1-2-546. whence,
A red fir 20" diam. bears N. 29° 09' W. 83.41 ft.
A red fir 20" diam. bears N. 28° 40' E. 37.35 ft.
Each blazed and scribed B.T. A. No. 1-2-546.

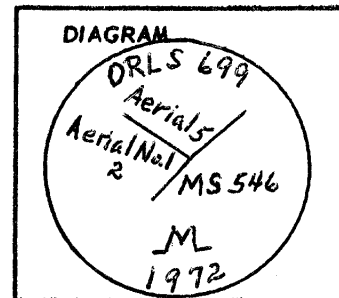


Description of corner evidence found:


Logging activity had scattered and partially buried the rock mound. The NW BT is in very good condition with the blaze and scribing very clear. The stump of the NE BT was found with no scribing.

Description of monument and accessories established to perpetuate the original location of this corner

With the aid of the BT's the original corner location was found. Set a 2" aluminum cap on a 1"x30" galvanized pipe, which is split of 8", and repiled the stone mound about 3' in diameter and 16" high. A Bearing Tree tag was placed on the 24" D. fir with the information listed above for the NW BT.

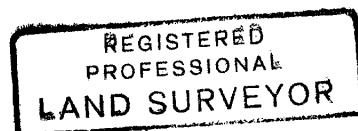

Leland Lee Myers

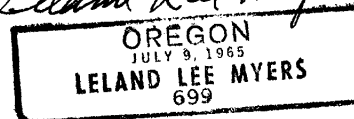

Office of County Surveyor County of Baker
State of Oregon, I hereby certify that the within instrument was filed in this office
for record on the 19 day of July, 1973, at 11 o'clock A.m., (signed)
by Tom Hanley
(COUNTY OFFICIAL) (DEPUTY)

10-35-16