


CERTIFIED RECORD OF LAND CORNER MONUMENTATION

History of original corner establishment:

Identical with amended location Center post.
A red fir post, 4' long, 4" square, set 18' in the ground with mound of earth, scribed A-E-546⁵⁴⁶ whence,
A red fir, 36" diam. bears N. 44° 26' E. 35.51 ft.
A red fir, 16" diam. bears S. 43° 08' W. 21.04 ft.
Each blazed and scribed B.T. A-E-C-546.
Discovery point in shaft, bears N. 62° 22' W. 1497 ft.

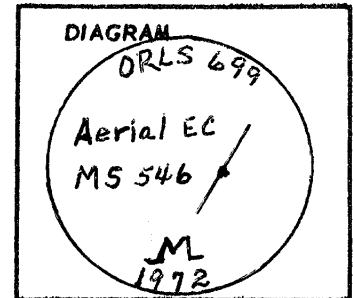


Description of corner evidence found:

The mound had been leveled down by time and logging activity. The NE BT which is a White Fir, is in good condition and the blaze has been grown over. The other BT is completely gone.

Description of monument and accessories established to perpetuate the original location of this corner

With the aid of the BT the corner location was re-established. Set a 2" aluminum cap on a 1"x30" galvanized pipe, which is split for 8", and made a rock mound around the monument approximately 2' in diameter and 1' high. A Bearing Tree tag was placed on the 36" White Fir with the information listed above for said tree.

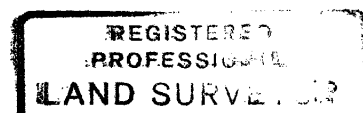

Leland Lee Myers



Office of County Surveyor County of Baker
State of Oregon, I hereby certify that the within instrument was filed in this office
for record on the 19 day of July, 1973, at 11 o'clock A.m., (signed)
by Tom Hanley
(COUNTY OFFICIAL) (DEPUTY)