


CERTIFIED RECORD OF LAND CORNER MONUMENTATION

History of original corner establishment:

A Tamarack post, 4 ft. long, 4" square, set 18" in the ground with mound of rocks, scribed A. 4-546. whence, S.W. Cor. Don Juan Quartz mill bears N. $23^{\circ} 48'$ W. 112.5 ft.

A black pine 12" diam. bears S. $50^{\circ} 15'$ W. 70.59 ft. Blazed and scribed B.T. A-4-546.

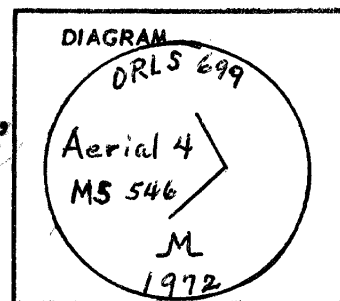

Description of corner evidence found:

Found a rock mound about 3' in diameter and 12" high in good condition. The corner is located on very swampy wet ground. The only BT had been sawed down then long-butted leaving the scribing. The Don Juan Quartz Mill is down, but the timbered foundation still shows it's original location.

Description of monument and accessories I established to perpetuate the original location of this corner

Set a 2" aluminum cap on a 1"x30" galvanized pipe, which is split for 8", in the center of the rock mound.

REGISTERED
PROFESSIONAL
LAND SURVEYOR

Leland Lee Myers

OREGON
JULY 9, 1965
LELAND LEE MYERS
699

Office of County Surveyor County of Baker
State of Oregon, I hereby certify that the within instrument was filed in this office
for record on the 19 day of July, 1973, at 11 o'clock A.m., (signed)
by Tom Hanley
(COUNTY OFFICIAL) (DEPUTY)

SURVEY NO. 10-35-18