

CERTIFIED RECORD OF LAND CORNER MONUMENTATION

History of original corner establishment:

Identical with Cor. No. 3. Don Juan Mill Site Lode
M.S. No. 339.

A pine post $3\frac{1}{2}$ ft. long, 4" square, set 18" in the
ground, with mound of rocks, and earth, scribed A-3-546.


whence, a red fir 20" diam. bears S. 87° W. 102.8 ft.

A red fir, 6" diam. bears N. $4^{\circ} 45'$ E. 69.2 ft.

Each blazed and scribed B.T.A-3-546.

Va. $26^{\circ} 40'$ E. local magnetic attraction very strong.

S. W. Cor. Don Juan Quartz Mill bears S. $60^{\circ} 48'$ E. 75.1 ft.

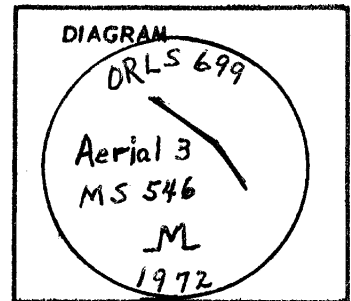

Description of corner evidence found:

Found a rock mound about 18" in diameter and 2" high and was in poor condition. The corner is located in an Alder patch on very wet ground and the vegetative growth had very nearly obliterated the corner. The NE BT, which is a White Fir, was found to be about 18" in diameter and the scribing was detectable. Only a stump with no scribing, which may have been the other BT, was found. The Don Juan Quartz Mill is down, but the timbered foundation still shows it's original location.

Description of monument and accessories | established to perpetuate the
original location of this corner

Set a 2" aluminum cap on a 1"x30" galvanized pipe, which is split for 8", in the center of the rock mound. A Bearing Tree tag was placed on the White Fir with the information listed above for said tree.

REGISTERED
PROFESSIONAL
LAND SURVEYOR

Leland Lee Myers

OREGON
JULY 9, 1965
LELAND LEE MYERS
699

Office of County Surveyor County of Baker
State of Oregon, I hereby certify that the within instrument was filed in this office
for record on the 19 day of July, 1973, at 11 o'clock A.m., (signed)
by Tom Hanley
(COUNTY OFFICIAL) (DEPUTY)

SURVEY NO. 10-35-19