


CERTIFIED RECORD OF LAND CORNER MONUMENTATION

History of original corner establishment:

Old corner destroyed by snow slide, also witness cors. to Cors No. 2-4-M.S. No. 339.
Set a fir post 3, $\frac{1}{2}$ ft. long, 4" square, 18" in the ground, with mound of rock, scribed A-2-546., whence,
A red fir, 24" diam. bears N. $89^{\circ} 33'$ E. 8.36 Ft.
A red fir 16" diam. bears S. $68^{\circ} 30'$ W. 18.35 ft.
Each blazed and scribed B.T. A-2-546.
ground very rough and broken.

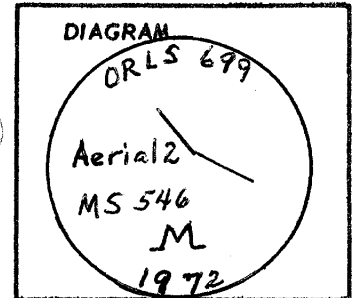

Description of corner evidence found:

Found a rock mound about 3' in diam. and 6" high in poor condition. The ground is very steep at the corner location in a narrow gorge. This has caused the mound to spread and trees had fallen across it. The two bearing trees had been broken off by snow and/or wind and are stubs about 20' high. The SW BT had slabbed off the blaze and scribing and was very rotten. The NE BT was in fair condition and should last for several years.

Description of monument and accessories | established to perpetuate the original location of this corner

Set a 2" aluminum cap on a 1"x30" galvanized pipe, which is split for 8", in the center of the rock mound. A Bearing Tree tag was placed on the 24" D. fir stub with the information listed above for said tree.

REGISTERED
PROFESSIONAL
LAND SURVEYOR

Leland Lee Myers

OREGON
JULY 9, 1965
LELAND LEE MYERS
699

Office of County Surveyor County of Baker
State of Oregon, I hereby certify that the within instrument was filed in this office
for record on the 19 day of July, 1973, at 11 o'clock A.m., (signed)
by Tom Hanley
(COUNTY OFFICIAL) (DEPUTY)

SURVEY NO. 10-35-20