


CERTIFIED RECORD OF LAND CORNER MONUMENTATION

History of original corner establishment:

Set a quartz stone 14x10x5 ins. 9 ins. in the ground for $\frac{1}{4}$ sec. cor. marked $\frac{1}{4}$ on N. face; from which
A black pine 6 ins. diam. bears north 18 lks. dist marked $\frac{1}{4}$ S., B.T.
A black pine 6 ins. diam. bears S. 60° E. 44 lks. dist. marked $\frac{1}{4}$ S., B.T.

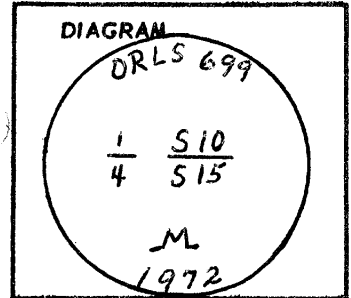

Description of corner evidence found:

Found the stone, but was unable to detect any markings. A small portion of the north BT was found with scribing visible. No sign of the other BT was found.

Description of monument and accessories I established to perpetuate the original location of this corner

Set a 2" aluminum cap on a 1"x30" galvanized pipe, which is split for 8", on the west side of the rock.



Office of County Surveyor County of Baker
State of Oregon, I hereby certify that the within instrument was filed in this office
for record on the 19 day of July; 1972, at 11 o'clock A.m., (signed)
by Tom Hanley
(COUNTY OFFICIAL) (DEPUTY)

SURVEY NO. 10-35-21