


CERTIFIED RECORD OF LAND CORNER MONUMENTATION

History of original corner establishment:

Identical with amended location cor., also identical with Cor. No. 1 Phoenix lode of this survey, also identical with Cor. No. 3 of the Do Do lode, M.S. 339. A pine post, 3, $\frac{1}{2}$ ft long, 4" square, set 18" in the ground, with mound of stone, scribed A-1-546., whence the $\frac{1}{4}$ Sec. Cor. on North boundary Sec. 15, T. 10 S., R. 35 E., WM, bears S. $48^{\circ} 42'$ E. 167.8 ft. A black pine, 20" diam. bears N. $35^{\circ} 30'$ W. 57.01 Ft. A Tamarack, 20" diam. bears S. $18^{\circ} 14'$ E. 30.74 ft. Each blazed and scribed B.T. A-1-546.

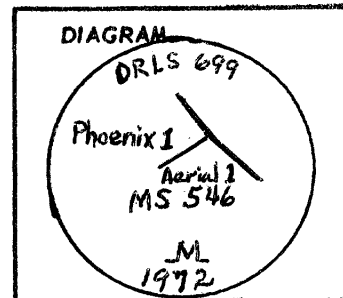


Description of corner evidence found:


Found a rock mound about 2' in Diameter and 6" high in Fair condition. The SE BT is now a stump which should last for some time and the scribing was legible. The black pine BT was down and rotted away and no scribing was found.

Description of monument and accessories established to perpetuate the original location of this corner

Set a 2" aluminum cap on a 1"x30" galvanized pipe, which is split for 8", in the center of the rock mound. A Bearing Tree tag was placed on the Western Larch stump with the information listed above for said tree.

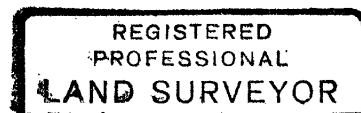

Leland Lee Myers

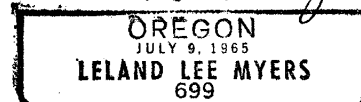

Office of County Surveyor County of Baker
 State of Oregon, I hereby certify that the within instrument was filed in this office
 for record on the 19 day of July, 1973, at 11 o'clock A.m., (signed)
 _____ by Tom Hanley
 (COUNTY OFFICIAL) (DEPUTY)

SURVEY NO. 10-35-22