


CERTIFIED RECORD OF LAND CORNER MONUMENTATION

History of original corner establishment:

Identical with Cor. No. 4, De Do Lode, M.S. 339
A black pine post $3\frac{1}{2}$ ft. long, 4" square, set 18"
in the ground with mound of rocks, scribed P 5-546,
whence
A tamarack 10" diam. bears S. $79^{\circ} 45'$ W. 33.5 ft.
A black pine 4" diam. bears N. 9° E. 28.2 ft.
each blazed and scribed B.T. P 5-546.

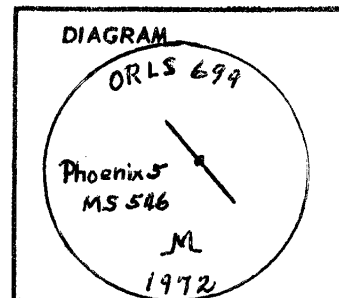


Description of corner evidence found:

Found a rock mound about 3' in diameter and 18" high in good condition.
The original 10" Tamarack BT was down with the scribing very visible.
The 4" black pine BT was completely gone. A peice of the original
4x4 corner post was found in the rock mound.

Description of monument and accessories | established to perpetuate the
original location of this corner

Set a 2" aluminum cap on a 1"x30" galvanized pipe, which is split for
8", in the center of the rock mound.

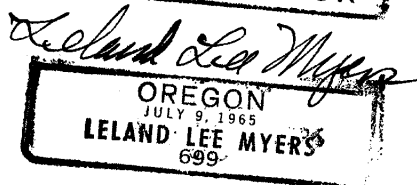

Office of County Surveyor County of Baker
State of Oregon, I hereby certify that the within instrument was filed in this office
for record on the 19 day of July, 1973, at 11 o'clock A.m., (signed)
by Tom Hanley
(COUNTY OFFICIAL) (DEPUTY)

SURVEY NO. 10-35-23