


CERTIFIED RECORD OF LAND CORNER MONUMENTATION

History of original corner establishment:

A black pine post $3\frac{1}{2}$ ft. long, 4" square, set 18" in the ground, with mound of rocks, scribed E. 3--563, whence
 A black pine 10" diam. bears S. $44^{\circ} 10'$ W. 86 ft.
 A black pine 5" diam. bears N. $00^{\circ} 45'$ W. 35.65 ft. each blazed and scribed B.T. E-3--563

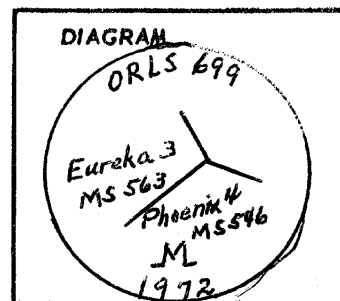


Description of corner evidence found:


Found a rock mound about 3' in diameter and 1' high in good condition. A small piece of the decayed original 4x4 corner post was found in the mound. The BT's are in good condition and have grown to be 16" and 12".

Description of monument and accessories I established to perpetuate the original location of this corner

Set a 2" aluminum cap on a 1"x30" galvanized pipe, which is split for 8", in the center of the rock mound. Attached Bearing Tree tags to the lodge pole pine BT's with the information listed above for each tree.

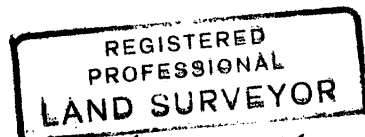

Leland Lee Myers

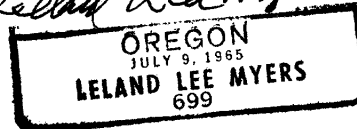

Office of County Surveyor County of Baker
 State of Oregon, I hereby certify that the within instrument was filed in this office
 for record on the 19 day of July, 1973, at 11 o'clock A.m., (signed)
 _____ by Tom Hanley
 (COUNTY OFFICIAL) (DEPUTY)

SURV 10-35-24