


CERTIFIED RECORD OF LAND CORNER MONUMENTATION

History of original corner establishment:

A pine post 4 ft. long, 4" square, set 18" in the ground, surrounded with a mound of earth and stone, scribed Ophir S. end cen. and Cor. No. 5-552, from which Discovery shaft bears N. $40^{\circ} 08'$ W. 652 ft. and N. $9^{\circ} 14'$ W. 7.6 ft.
Location S. end cen. post bears S. $40^{\circ} 09'$ E. 15.6 ft.
A tamarack 8" diam. bears S $37^{\circ} 20'$ E. 15.6 ft., blazed and scribed Ophir S. end cen. and 5-552 B.T.

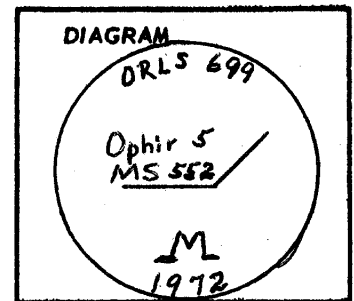


Description of corner evidence found:


Found a rock mound about 2' in diameter and 6" high in fair condition. The BT has grown to be 12". This corner is very near the center line as staked of the new Whitney-Greenhorn road and will be destroyed if the road is constructed as staked.

Description of monument and accessories I established to perpetuate the original location of this corner

Set a 2" aluminum cap on a 1"x30" galvanized pipe, which is split for 8", in the center of the rock mound. A Bearing Tree tag was attached to the BT with the information listed above for said tree.

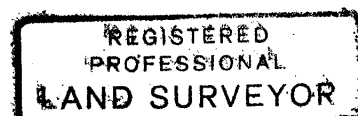

Leland Lee Myers

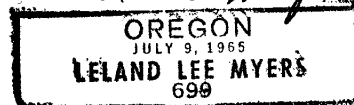

Office of County Surveyor County of Baker
State of Oregon, I hereby certify that the within instrument was filed in this office
for record on the 19 day of July, 1973, at 11 o'clock A.m., (signed)
..... by Tom Hanley
(COUNTY OFFICIAL) (DEPUTY)

COPY

10-35-26