


CERTIFIED RECORD OF LAND CORNER MONUMENTATION

History of original corner establishment:

A pine post 4 ft. long, 5" square, set 18" in the ground, surrounded with a mound of earth, scribed Ophir 6—552, from which
 Location S.W. cor. post bears S. 25° 20' E. 200 ft.
 A pine 8" diam. bears N. 3° 25' E. 12.2 ft.
 A pine 8" diam. bears N. 41° 20' W. 25.8 ft.
 each blazed and scribed Ophir 6—552 E.T.

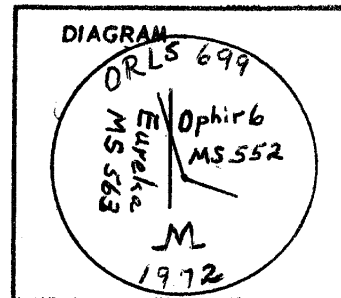


Description of corner evidence found:

Found a rock mound about 2' in diameter and 6" high in fair condition. The lodge pole pine BT's had grown to 14" and 12" and are in good condition.

Description of monument and accessories | established to perpetuate the original location of this corner

Set a 2" aluminum cap on a 1"x30" galvanized pipe, which is split for 8", in the center of the rock mound. Attached Bearing Tree tags to the BT's with the following information;

14" LP N3°E 12.5'
 12" LP N41°W 26.1'

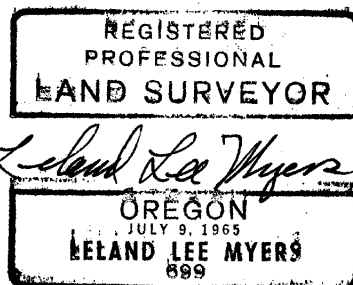

Office of County Surveyor County of Baker
 State of Oregon, I hereby certify that the within instrument was filed in this office
 for record on the 19 day of July, 1973, at 11 o'clock A.m., (signed)
 _____ by Tom Hanley
 (COUNTY OFFICIAL) (DEPUTY)

SURVEY 10-35-27