


NOTE: True meridian used this survey is based on Line 1-2 of the Diadem claim of the original survey of 1903.

Variation 21°13' ± 22°45' East

**SURVEY of MINING CLAIM BOUNDARY**  
 Mineral Survey No. 547  
 Sec's 16 & 17, T10S, R35E W1M.  
 Baker & Grant Counties, Oregon  
 Wallowa Whitman National Forest  
 Scale 1" = 400' Date 11-5-73

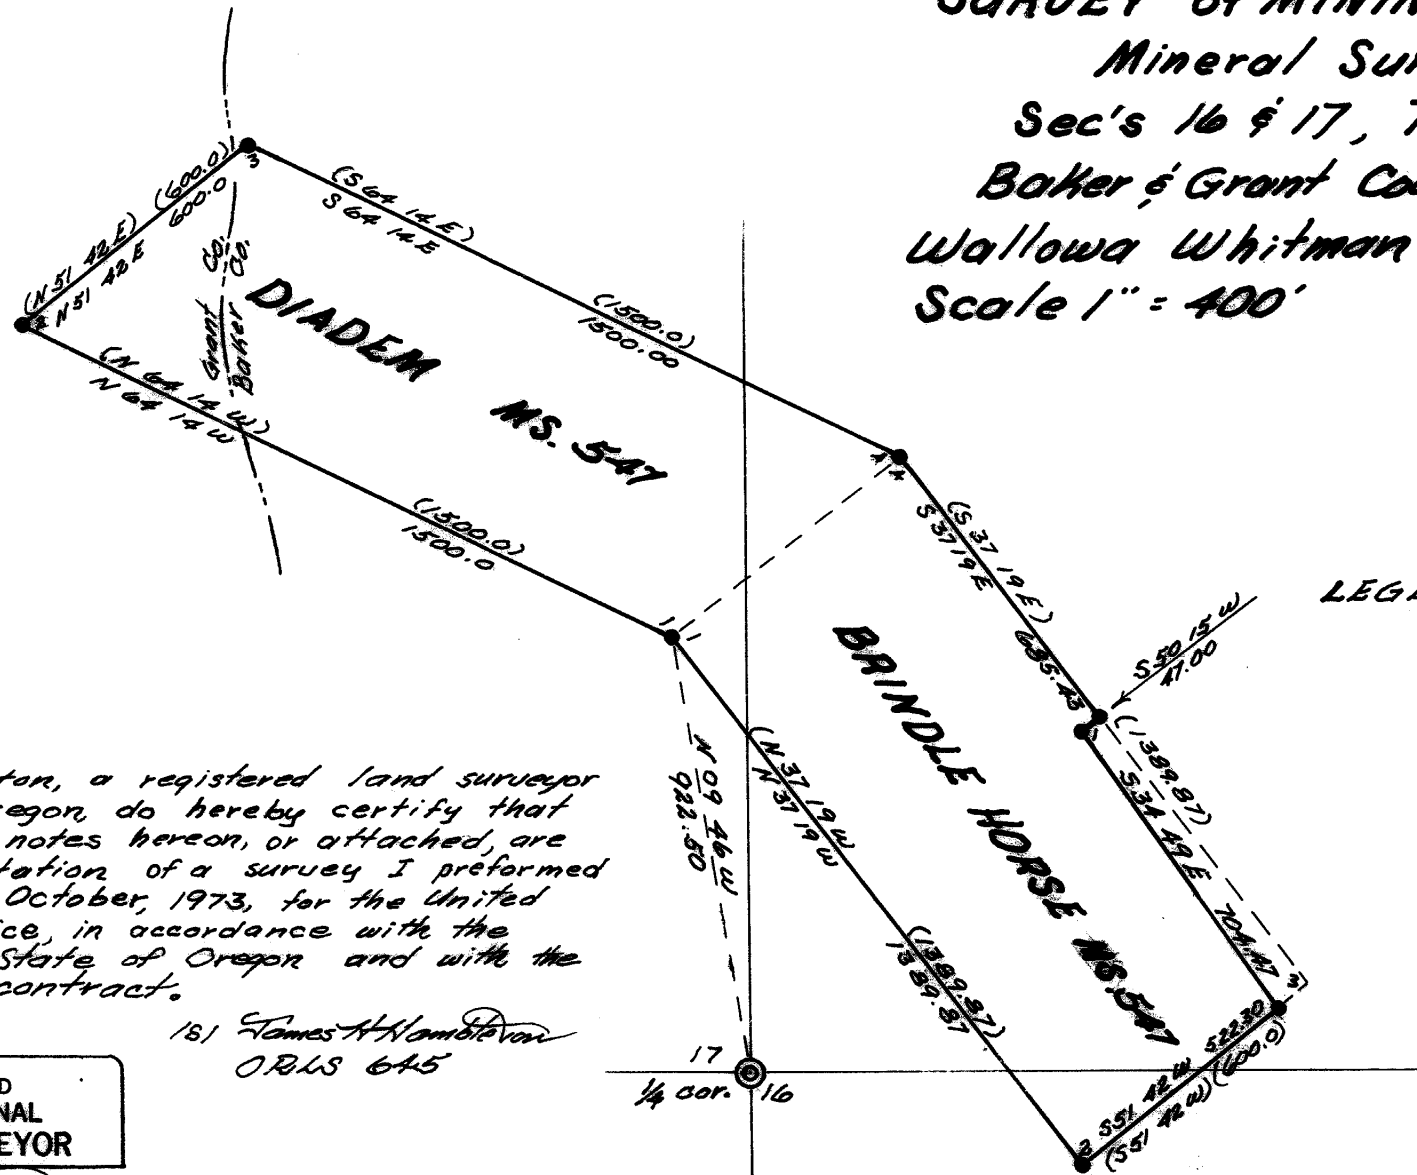

**LEGEND:**  
 • Monument set this survey.  
 — Line ran this survey.  
 --- Line projected only.

I, James H. Hambleton, a registered land surveyor in the State of Oregon, do hereby certify that this plat and the notes hereon, or attached, are a correct representation of a survey I performed during August thru October, 1973, for the United States Forest Service, in accordance with the statutes of the State of Oregon and with the Articles of my contract.

181 James H. Hambleton  
 ORLS 645

REGISTERED  
 PROFESSIONAL  
 LAND SURVEYOR

*James H. Hambleton*

OREGON  
 JULY 18, 1964  
 JAMES H. HAMBLETON

FILED Nov. 30, 1973  
 BAKER COUNTY SURVEYOR  
 SURVEY NO. 10-35-29