

CERTIFIED RECORD OF LAND CORNER MONUMENTATION

History of original corner establishment:


Corner was established in 1904 by August W. Mohr deputy Mineral Surveyor.

Set was a post 6 in. sq. 4 ft. long 18 in. in ground in a raised mound of earth, scribed 1-1-555 GE & HF from which:

a tamarack 18 in. in dia. bears S 82 E, 27.0 ft.

a tamarack 24 in. in dia. bears S 30 40 E, 5.5 ft.

Both trees scribed 1-1-555 BT.

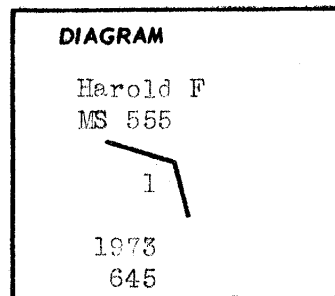

Description of corner evidence found:

At corner location I found a mound of stone and a rotted post with scribing on the face. Also I found two bearing trees that were tamarack and were dead.

Description of monument and accessories I established to perpetuate the original location of this corner

As the evidence agrees with the original survey, I set a 36 in. long 2 in. galv. iron pipe with a 2 in. brass cap in a mound of stone. Cap stamped as shown in the diagram.

New bearing trees:

a fir 8 in. in dia. bears N 52 W, 3.1 ft., scribed Har. R 1 MS 555 BT with a brass tag stamped LS 645.

a fir 8 in. in dia. bears N 42 30 E, 18.9 ft, scribed Har. F 1 MS 555 BT with a brass tag stamped LS 645.

REGISTERED
PROFESSIONAL
LAND SURVEYOR

I hereby certify the above corner monument was re-established as herein above, in October 1973.

Witness: Brad D. Johnson

OREGON
JULY 10, 1964
JAMES H. HAMBLETON
645

Office of County Surveyor County of Baker
State of Oregon, I hereby certify that the within instrument was filed in this office
for record on the 30 day of November, 1973, at 9:30 o'clock A.m., (signed)
by Tom Hanley
(COUNTY OFFICIAL) (DEPUTY)

SHAW 10-35-36