

CERTIFIED RECORD OF LAND CORNER MONUMENTATION


History of original corner establishment:

Corner was established in 1904 by August W. Mohr deputy Mineral Surveyor.

Set was a pine post 4 in. sq. 3 ft. long set 18 in. in the ground scribed 4-555-Danae in a raised mound of earth, from which:

a forked pine 36 in. dia. bears N 30 W, 61 ft. scribed 4-555-Danae BT.

a pine 18 in. dia. bears N 79 20 W, 22 ft. scribed 4-555-Danae BT.

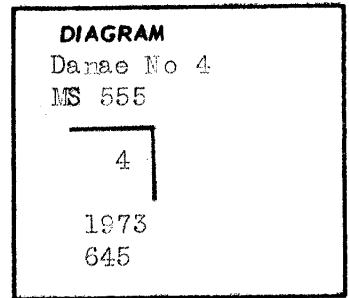

Description of corner evidence found:

At location of corner I found a mound of earth and stone with a post of which was not original. Also, I found a white fir snag with a blaze grown over 22 ft. away and a pine snag 61 ft. away with the scribing visible.

Description of monument and accessories I established to perpetuate the original location of this corner

As the evidence agreed with the original survey with the exception of the type of tree, I set a 36 in. long 2 in. galv. iron pipe with a 2 in. brass cap in a mound of stone. Cap marked as shown in diagram.

New bearing trees:

a pine 20 in. dia. bears N 62 W, 79.1 ft. scribed D-4 MS 555 BT with a brass tag stamped LS 645.

a fir 4 in. dia. bears S 48 E, 19.3 ft. scribed D-4 MS 555 BT with a brass tag stamped LS 645.

REGISTERED
PROFESSIONAL
LAND SURVEYOR

I hereby certify the above corner monument was re-established as herein above, in Oct. 1973.

Witness: Brad D. Johnson

OREGON
JULY 10, 1964
JAMES H. HAMBLETON
645

Office of County Surveyor County of Baker
State of Oregon, I hereby certify that the within instrument was filed in this office
for record on the 30 day of November, 1973, at 9:30 o'clock A.m., (signed)
by Tom Hanley
(COUNTY OFFICIAL) (DEPUTY)

10-35-43