

CERTIFIED RECORD OF LAND CORNER MONUMENTATION

History of original corner establishment:


Corner was established in 1904 by August W. Mohr deputy Mineral Surveyor.

Set was a post 4 in. sq. 3 ft. long 18 in. in the ground scribed 4-555 YJ in a raised mound of earth from which:

a pine 18 in. dia. bears N 38 20 W, 14.7 ft. scribed 4-555 YJ BT

a pine 10 in. dia. bears S 75 40 W, 27.4 ft. scribed 4-555 YJ BT

a pine 18 in. dia. bears S 53 40 E, 13.8 ft, scribed 4-555 YJ BT

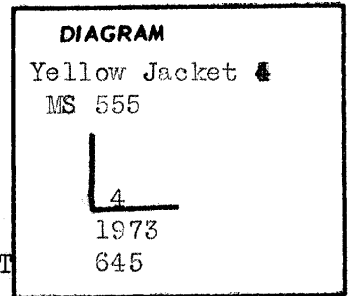

Description of corner evidence found:

At corner location I found a mound of earth and stone and rotted post. Also the bearing trees were all dead and lying on the ground - some were badly rotted.

Description of monument and accessories I established to perpetuate the original location of this corner

As the evidence agrees with the original survey, I set a 36 in. long 2 in. galv. iron pipe with a 2 in. brass cap in a mound of stone. Cap marked as shown in diagram.

New bearing trees:

a fir 8 in. dia. bears N 79 W, 26.5 ft. scribed YJ-4 MS 555 BT with a brass tag stamped LS 645.

A fir 10 in. dia. bears S 01 W, 16.7 ft. scribed YJ-4 MS 555 BT with a brass tag stamped LS 645.

I hereby certify the above corner monument was re-established as herein above, in Oct. 1973.

Witness: *Brad D. Johnson*

REGISTERED
PROFESSIONAL
LAND SURVEYOR

James H. Hambleton

OREGON
JULY 10, 1964
JAMES H. HAMBLETON
645

Office of *County Surveyor* County of *Baker*
State of *Oregon*, I hereby certify that the within instrument was filed in this office
for record on the *30* day of *November*, 19*73*, at *9:20* o'clock *A.m.*, (signed)
by *Tom Hanley*
(COUNTY OFFICIAL) (DEPUTY)

10-35-45