

CERTIFIED RECORD OF LAND CORNER MONUMENTATION

History of original corner establishment:

Corner was established in 1904 by August W. Mohr deputy Mineral Surveyor.

Set was an X on a large rock in place approx 6 x 5 x 4 ft. level with surface of ground from which:

a pine 3.5 ft. dia. bears N 38 45 W 57 ft. scribed 3-555 YJ BT

a pine 2.5 ft. dia. bears S 58 W, 32 ft. scribed 3-555 YJ BT.

DIAGRAM

Yellow Jacket 3
MS 555

3

1973
645

Description of corner evidence found:

At corner location I found a large rock with an X on the edge that checked to the two bearing trees that were alive and in good condition.

Description of monument and accessories I established to perpetuate the original location of this corner


As the evidence agrees to the original survey, I set a 36 in. long 2 in galv. iron pipe with a 2 in. brass cap along the edge of the rock and over the X Leaving the X undisturbed. Placed a mound of stone around pipe. Cap marked as shown in diagram.

No new bearing trees.

I hereby certify the above corner monument was re-established as herein above, in Oct. 1973.

Witness: *Brad D. Johnson*

REGISTERED
PROFESSIONAL
LAND SURVEYOR

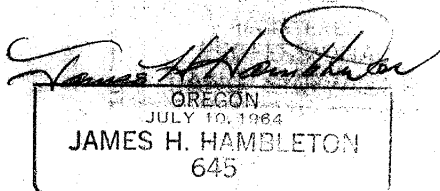

Office of *County Surveyor* County of *Baker*
State of *Oregon*, I hereby certify that the within instrument was filed in this office
for record on the *30* day of *November*, 19*73*, at *9:30* o'clock *A.*m., (signed)
by *Torn Hambleton*
(COUNTY OFFICIAL) (DEPUTY)

10-35-46