

CERTIFIED RECORD OF LAND CORNER MONUMENTATION

History of original corner establishment:


Corner was established in 1904 by August W. Mohr deputy Mineral Surveyor.

Set was post - fir- 6 in. sq. 3 ft. long set 18 in. in ground scribed 2-555 YJ from which:

a pine 18 in. dia. bears S 10 20 E 54 ft. scribed 2-555 YJ BT

a pine 16 in. dia. bears S 20 E, 36.4 ft. scribed 2-555 YJ BT

a pine 34 in. dia. bears N 48 E, 37 ft. scribed 2-555 YJ BT.

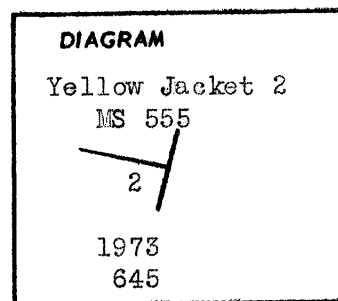

Description of corner evidence found:

At corner location I found three stumps from logging activities that fit the description of the original survey for this corner, no other evidence.

Description of monument and accessories I established to perpetuate the original location of this corner

As the stumps agree to the described bearing trees I located the corner position from the stumps and set a 36 in long 2 in. galv. iron pipe with a 2 in. brass cap in a mound of stone. Cap marked as shown in diagram.

New bearing trees:

a fir 10 in. dia. bears S 20 E, 16.5 ft. scribed YJ-2 MS555 BT with a brass tag stamped LS 645

a fir 12 in. dia. bears N 54 W, 23.7 ft. scribed YJ-2 MS 555 BT with a brass tag stamped LS 645.

REGISTERED
PROFESSIONAL
LAND SURVEYOR

I hereby certify the above corner monument was re-established as herein above, in Oct. 1973.

Witness: Brad D. Johnson

OREGON
JULY 10, 1954
JAMES H. HAMBLETON
645

Office of County Surveyor County of Baker
State of Oregon, I hereby certify that the within instrument was filed in this office
for record on the 30 day of November, 19 73, at 9:30 o'clock A.m., (signed)
by Tom Hanley
(COUNTY OFFICIAL) (DEPUTY)

10-35-47