

CERTIFIED RECORD OF LAND CORNER MONUMENTATION

History of original corner establishment:


Corner was established in 1904 by August W. Mohr deputy Mineral Surveyor.

Set was a rock in place 8 ft. x 6 ft. x 5 ft. with an X chiseled on the South end, from which:

a fir 30 in dia. bears S 65 E, 3.5 ft. scribed 3-555 BT.

a fir 15 in. dia. bears N 45 30 W, 28.6 ft. scribed 3-555 BT.

a fir 12 in. dia. bears S 65 E, 6.7 ft. scribed 3-555 BT.

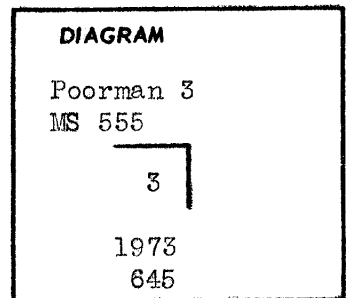

Description of corner evidence found:

At corner location I found the bearing trees alive and in good condition - only one was open and scribing 3-555 BT was visible. Found X on rock.


Description of monument and accessories I established to perpetuate the original location of this corner

As the evidence agrees with the original survey I set a 36 in. long 2 in. galv. iron pipe with a 2 in. brass cap in a mound of stone at the corner location. Cap marked as shown in diagram.


No new bearing trees were set.

I hereby certify the above corner monument was re-established as herein above, in Oct. 1973.

Witness: *Brad D. Johnson*

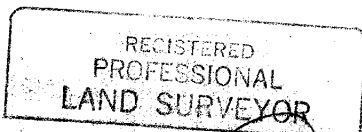

James H. Hambleton

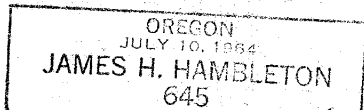

Office of *County Surveyor* County of *Baker*
State of *Oregon*, I hereby certify that the within instrument was filed in this office
for record on the *30* day of *November*, 1973, at *9:00* o'clock *A.* m., (signed)
by *Tom Hanley*
(COUNTY OFFICIAL) (DEPUTY)

10-35-49