

CERTIFIED RECORD OF LAND CORNER MONUMENTATION

History of original corner establishment:


Corner was established in 1904 by August W. Mohr deputy Mineral Surveyor.

Set was a post 5 ins. sq. 3.5 ft. long set 18 in. in the ground scribed 2-3-555 in a raised mound of earth, from which:

a fir 18 in. dia. bears S 79 E, 22 ft. scribed 2-3-555 BT.

a fir 16 in. dia. bears N 31 30 E, 41 ft. scribed 2-3-555 BT.

a fir 28 in. dia. bears N 55 W, 33 ft. scribed 2-3-555 P MC BT.

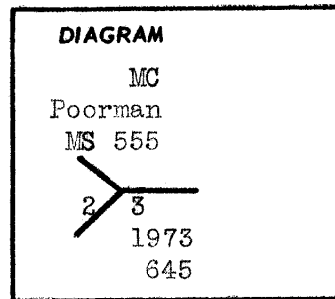

Description of corner evidence found:

At corner location I found a mound of earth and stone and one live bearing tree N 55 W, 33 ft. and one dead tree lying on the ground scribed 2-3-555 BT N 31 30 E, 41 ft. from corner. The other bearing tree was destroyed in road construction.

Description of monument and accessories I established to perpetuate the original location of this corner


As the evidence agrees to the original survey, I set a 36 in. long 2 in. galv. iron pipe with a 2 in. brass cap in a mound of stone. Cap marked as shown in diagram.

New bearing tree:


a fir 10 in. dia. bears S 16 W, 41.6 ft. scribed 2-3-555 BT with a brass tag stamped LS 645.

I hereby certify the above corner monument was re-established in Oct. 1973 as herein above.

Witness: Brad D. Johnson

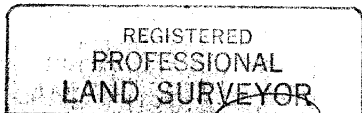

James H. Hambleton

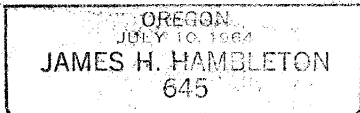

Office of *County Surveyor* County of *Baker*
State of *Oregon*, I hereby certify that the within instrument was filed in this office
for record on the *30* day of *November*; 19*73*, at *9:30* o'clock *A.*m., (signed)
by *Tom Hanley*
(COUNTY OFFICIAL) (DEPUTY)

SURVEY NO. *10-35-50*