


CERTIFIED RECORD OF LAND CORNER MONUMENTATION

History of original corner establishment:

Corner was established in 1903 by Arthur B. Browne deputy Mineral Surveyor.

Set was a post 5 ft. long 6 in. sq. set 2 ft. in the ground with a mound of earth and stone, scribed Cor No 1 D. Sur. 547 from which:

a fir 12 in. dia. bears S 29 40 E, 89 ft. scribed BT Cor 1 547.

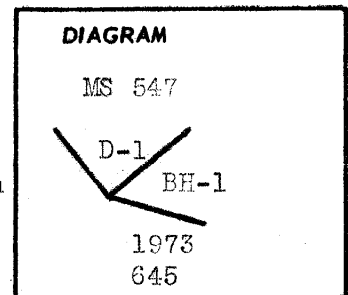

Description of corner evidence found:

At corner location I found a mound of stone and old rotted post in the ground also I found the bearing tree alive and good condition.

Description of monument and accessories I established to perpetuate the original location of this corner

The evidence found agrees with the original survey although the bearing tree distance does not check - there seems to be an error as the distance was only 36.8 ft. instead of 89 ft. At 89 ft. there is no evidence at all. Therefore using the old post hole I set a 36 in. long 2 in. galv. iron pipe with a 2 in. brass cap in a mound of stone. Cap marked as shown in diagram.

New bearing tree:

a fir 16 in. dia. bears S 16 W, 138.5 ft. scribed Cor 1 MS 547 BT with a brass tag stamped LS 645.

I hereby certify the above corner monument was re-established as herein above, in Oct. 1973.

Witness: *Brad D. Johnson*

REGISTERED
PROFESSIONAL
LAND SURVEYOR

OREGON
JULY 10, 1964
JAMES H. HAMBLETON
645

Office of *County Surveyor* County of *Baker*
State of *Oregon*, I hereby certify that the within instrument was filed in this office
for record on the *30* day of *November*, 19*73*, at *9:30* o'clock *A.*m., (signed)
by *Tom Hawley*
(COUNTY OFFICIAL) (DEPUTY)

10-35-52