

CERTIFIED RECORD OF LAND CORNER MONUMENTATION


History of original corner establishment:

Corner was established in 1903 by Arther B. Browne deputy Mineral Surveyor.

Set was a post 5 ft. long 6 in. sq. set 2 ft. in the ground with a mound of earth and stone about the base scribed Cor. No. 3 D. 547., from which:

a fir 48 in. dia. bears S 74 E, 90.5 ft. scribed BT Cor No 3 D 547.

a fir 16 in. dia. bears S 33 15 E, 19.5 ft. scribed BT Cor 3 D 547.

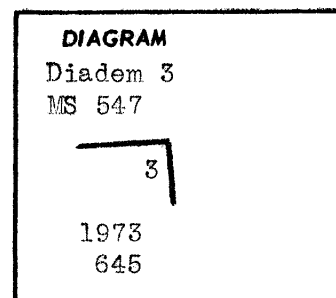

Description of corner evidence found:

At corner location I found a mound of stone and a post with the two bearing trees as described in the original survey.

Description of monument and accessories I established to perpetuate the original location of this corner


As the evidence agrees with the original survey, I set a 36 in. long 2 in. galv. iron pipe with a 2 in. brass cap in a mound of stone. Cap marked as shown in diagram.

New bearing trees:


a fir 11 in. dia. bears S 66 E, 120.0 ft. scribed Cor. No 3-D MS 547 BT with a brass tag stamped LS 645.

I hereby certify the above corner monument was re-established as herein above, in Oct. 1973.

Witness: *Brad D. Johnson*

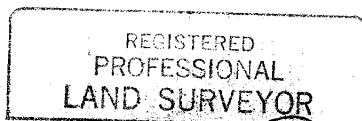

James H. Hambleton

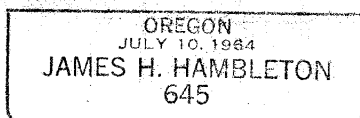

Office of County Surveyor County of Baker
State of Oregon, I hereby certify that the within instrument was filed in this office
for record on the 30 day of November, 1973, at 2:22 o'clock A.m., (signed)
..... by Tom Hanley
(COUNTY OFFICIAL) (DEPUTY)

10-35-54