

CERTIFIED RECORD OF LAND CORNER MONUMENTATION


History of original corner establishment:

Corner was established in 1903 by Arthur B. Browne deputy Mineral Surveyor.

Set was a post 5 ft. long 6 in. sq. set 2 ft. in the ground with a mound of earth and stone scribed Cor No 2 BH Sur 547. from which:

a pine 12 in. dia. bears N 43 W, 31 ft. scribed BT Cor 2 BH Sur 547.

a fir 8 in. dia. bears N 08 30 E, 28.0 ft. scribed BT Cor 2 BH Sur 547.

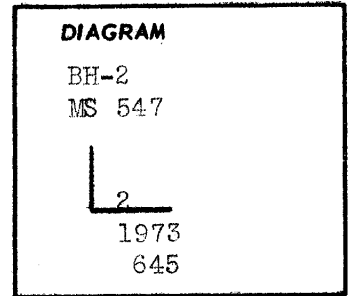

Description of corner evidence found:

At corner location I found mound of stone and a post with both bearing trees. The fir is alive and pine is dead and on the ground. I found the distance to check but bearing to the fir is in error - should have been N 24 E.

Description of monument and accessories I established to perpetuate the original location of this corner

As the evidence agrees with the original survey, I set a 36 in. long 2 in. galv. iron pipe with a 2 in. brass cap in a mound of stone. Cap marked as shown in diagram.

New bearing tree:

a fir 8 in. dia. bears N 57 W, 30.7 ft. scribed BH-2 MS 547 BT with a brass tag stamped LS 645.

I hereby certify the above corner monument was re-established as herein above, in Oct. 1973.

Witness: *Brad D. Johnson*

REGISTERED
PROFESSIONAL
LAND SURVEYOR

James H. Hambleton

OREGON
JULY 10, 1964
JAMES H. HAMBLETON
645

Office of County Surveyor County of Baker
State of Oregon, I hereby certify that the within instrument was filed in this office
for record on the 30 day of November, 1973, at 9:30 o'clock A.m., (signed)
by Tom Hanley
(COUNTY OFFICIAL) (DEPUTY)

10-35-58