

CERTIFIED RECORD OF LAND CORNER MONUMENTATION


History of original corner establishment:

Corner was established in 1902 by Arthur Philbrick US deputy Mineral Surveyor.

Set was a post 4 ft. long 4 in. sq. set 12 in. in ground in a mound of earth scribed 2-4-1 458 from which:

a pine 8 in. dia. bears S 30 19 E, 23.9 ft. scribed BT 2-4-1 458.

a pine 4 in. dia. bears S 75 56 W, 31.1 ft. scribed BT 2-4-1 458.

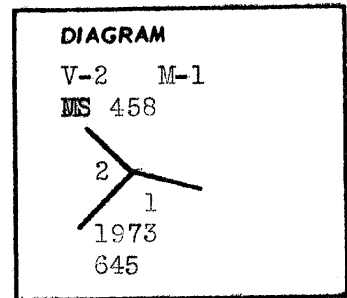

Description of corner evidence found:

At corner location I found a mound of earth and stone with a post not being the original. Also the 8 in. bearing tree is now 12 in. dia. - the other tree is dead and gone.

Description of monument and accessories I established to perpetuate the original location of this corner

As the evidence found agrees with the original survey, I set a 36 in. long 2 in. galv. iron pipe with a 2 in. brass cap in a mound of stone. Cap marked as shown in diagram.

New bearing tree:

a pine 12 in. dia. bears S 72 E 35.6 ft. scribed V-2 M-1 MS 458 BT with a brass tag stamped LS 645.

I hereby certify the above corner monument was re-established as hereing above, in Oct. 1973.

Witness: Brad D. Johnson

REGISTERED
PROFESSIONAL
LAND SURVEYOR

James H. Hambleton

OREGON
JULY 10, 1964
JAMES H. HAMBLETON
645

Office of County Surveyor County of Baker
State of Oregon, I hereby certify that the within instrument was filed in this office
for record on the 30 day of November, 1973, at 9:20 o'clock A.m., (signed)
by Tom Hambleton
(COUNTY OFFICIAL) (DEPUTY)

10-35-62