


CERTIFIED RECORD OF LAND CORNER MONUMENTATION

History of original corner establishment:

80.00 Set a basalt stone 12 x 10 x 6 in. 8 in. in ground for cor. to Secs. 11, 12, 13, and 14 marked with 4 notches on S. and 1 notch on E. edges from which
A tamarac 24 in. in diam. bears N. 35° E. 53 lks. dist. marked T. 10 S., R. 35 E., S. 12 B.T.
A tamarac 18 in. in diam. bears S. 40° E. 121 lks. dist. marked T. 10 S., R. 35 E., S. 13 B.T.
A tamarac 12 in. in diam. bears S. 40° W. 63 lks. dist. marked T. 10 S., R. 35 E., S. 14 B.T.
A fir 7 in. in diam. bears N. 45° W. 17 lks. dist. marked T. 10 S., R. 35 E., S. 11 B.T.

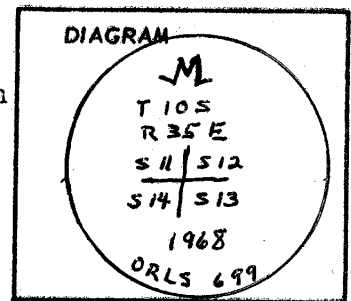

Description of corner evidence found:

B.T.s: a larch 28 in. in diam. bears N. 25° E. 35 ft.
a W. fir 28 in. in diam. bears N. 53° W. 11.2 ft.
a larch 22 in. in diam. bears S. 50° W. 41 ft.

Other B.T. was down and deteriorated. Did not find marked rock, but set corner from B.T.s.

Description of monument and accessories I established to perpetuate the original location of this corner

Set iron pipe 1 x 30 in. with brass cap, jutting from ground 10 in.

Dense W. fir and spruce thicket.



Office of County of
State of , I hereby certify that the within instrument was filed in this office
for record on the day of; 19....., at o'clockm., (signed)
..... by
(COUNTY OFFICIAL) (DEPUTY)

FILED Jan 7, 1981
DAKER COUNTY SURVEYOR
SURVEY NO. 10-35-67

FILED
COUNTY SURVEYOR
.....