


CERTIFIED RECORD OF LAND CORNER MONUMENTATION

History of original corner establishment:

40.09 Set a post 3 ft. long, 3 in. square, 24 in. in ground for $\frac{1}{4}$ cor. marked $\frac{1}{4}$ S. on N. face from which
A fir 12 in. in diam. bears N. 5° E. 15 lks. dist.
marked $\frac{1}{4}$ S. B.T.
A black pine 8 in. in diam. bears S. 10° E. 12 lks. dist.
marked $\frac{1}{4}$ S. B.T.

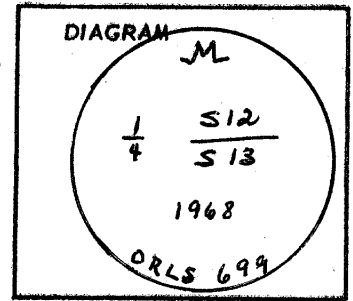

T. 10S. R. 35E.

Description of corner evidence found:

B.T.: a LP pine 12 in. in diam. bears S. 14° E. 7.9 ft.

Found rotted stump of other B.T. No other corner evidence found.

Description of monument and accessories I established to perpetuate the original location of this corner

Set iron pipe 1 x 30 in. with brass cap, jutting from ground 16 in.
Monument surrounded by rocks.



Office of County of
State of , I hereby certify that the within instrument was filed in this office
for record on the day of , 19..... , at o'clockm., (signed)
..... by
(COUNTY OFFICIAL) (DEPUTY)

FILED Jan 7, 1981
BAKER COUNTY SURVEYOR
SURVEY NO. 10-35-68