


CERTIFIED RECORD OF LAND CORNER MONUMENTATION

History of original corner establishment:

40.00 Set a basalt stone 16 x 8 x 6 in. 11 in. in ground for $\frac{1}{4}$ cor. marked $\frac{1}{4}$ on W. face from which
A black pine 6 in. in diam. bears N. 85° E. 59 lks. dist. marked $\frac{1}{4}$ S. B.T.
A black pine 7 in. in diam. bears S. 15° W. 47 lks. dist. marked $\frac{1}{4}$ S. B.T.

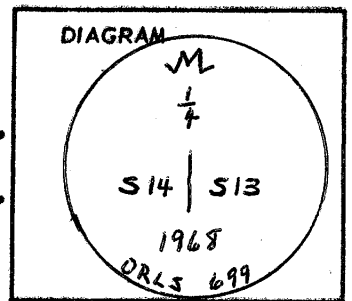

Description of corner evidence found:

Found no evidence of this corner and had to establish it by coordinates.

Description of monument and accessories I established to perpetuate the original location of this corner

Set iron pipe 1 x 30 in. with brass cap, jutting from ground 10 in.
Ref. Tree: a pine 30 in. in diam. bears N. 13° E. 46.5 ft.
Corner is in middle of small meadow-like opening.



Office of..... County of.....
State of....., I hereby certify that the within instrument was filed in this office
for record on the day of; 19....., at..... o'clockm., (signed)
..... by
(COUNTY OFFICIAL) (DEPUTY)

FILED Jan 7, 1981

BAKER COUNTY SURVEYOR

SURVEY NO. 10-35-70